




MAY 1980 ZB
F.W.M. JR.

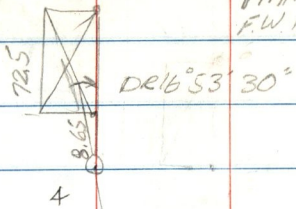

4

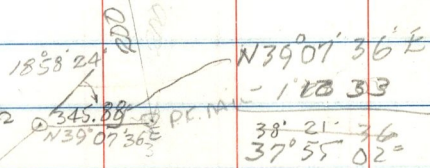

N 39° 07' 36\"/>
~~1 2 3 3~~
 38° 21' 76
 37° 55' 02"

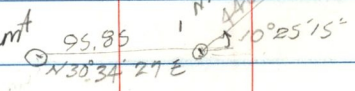

~~95° 45'~~

1st (96° 36' 48")

2nd (96° 48')

74.47

OR 17° 40'

70° 27'

46 47 15
 + 38 21 36

 84 68 51

N 46° 47' 15" W
 N 39° 07' 36" E

 85° 54' 51"

N 40° 15' E

87° 02'

~~4~~