


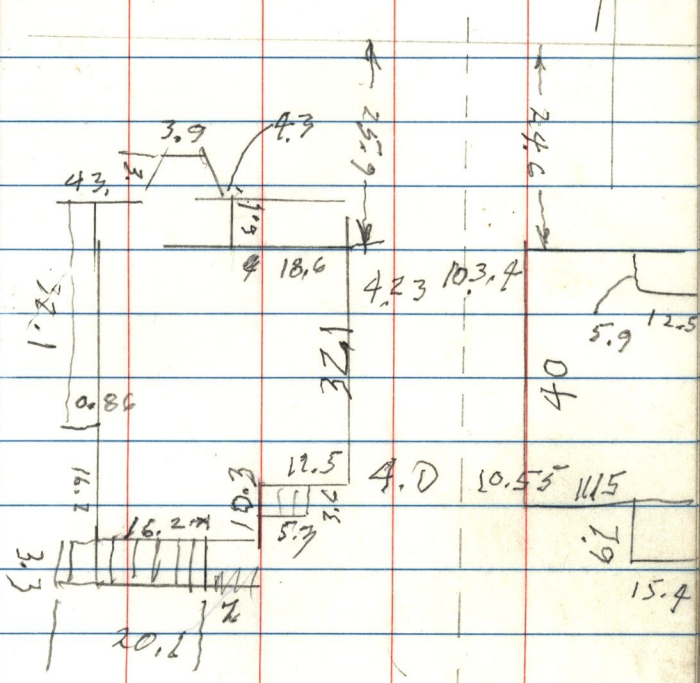
B-7-80  
Vern P

Cleat & Hat

35

Geo. - 

2.6



Weber County Land