



100 →

107.



100

99

95

11.65

94

94.8

~~94~~

BOTTOM OF PIPE N. DRAIN DITCH

10.45

10.30

N. END OPEN DRAIN.


PIPE ACROSS DITCH

3rd LATH

2nd LATH

FIRST LATH

PIPE IN H

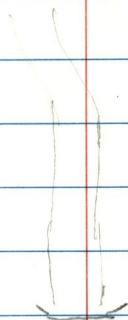

5.32

1.9

2.4

