


N.E. 1/4 SEC. 10, T. 6N, R. 2W  
MILL CREEK SUBDIVISION

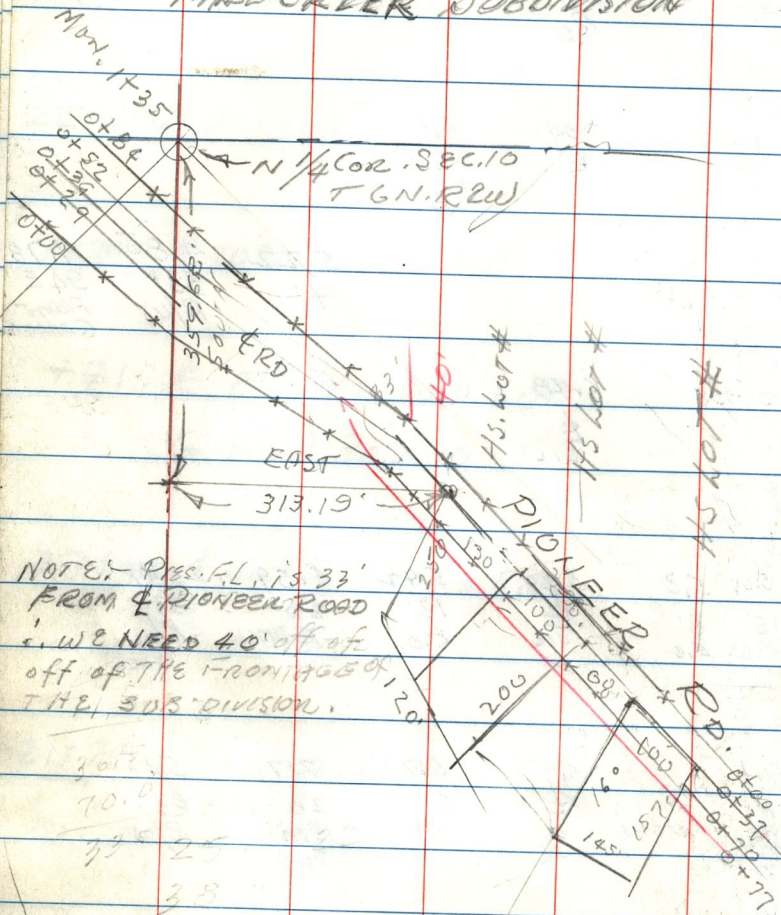

NOTE: Pres. F.L. is 33'  
FROM & PIONEER ROAD  
∴ WE NEED 40' off of  
off of THE FRONTAGE of 120'  
THE SUBDIVISION.

Notes  
70.0  
39.0 25  
3.8  
4.6  
720.29  
33 40  
3782

0+60  
0+54  
0+27  
0+77