SLATERVILLE DIST. MC 50-50

CREEK TRAILS SUB) JOB# MC 81-102)

70.40
86.49
156.89

12-4-81

JACK, MICKIE & FRED

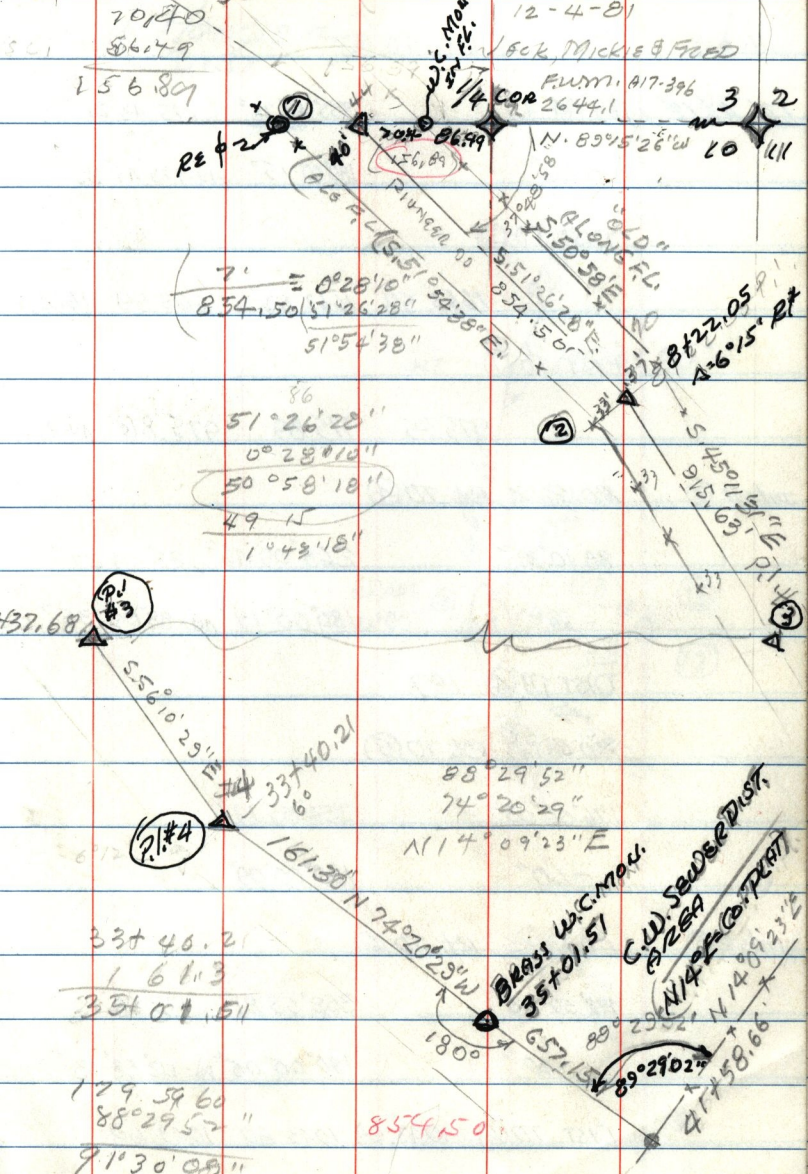

7' = 0°28'10"
854.50 51°26'28"
51°54'38"

51°26'28"
0°28'10"
50°58'18"
49 15
1°43'18"

88°29'52"
74°20'29"
N14°09'23"E

33+40.21
161.3
35+01.51

179.59 60
88°29'52"
91°30'08"

iff 9'23"

Cont Pg. 52