
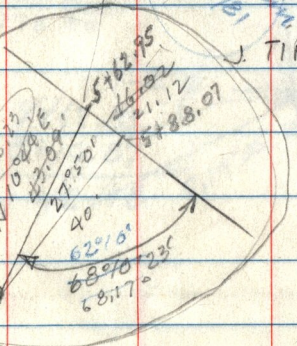
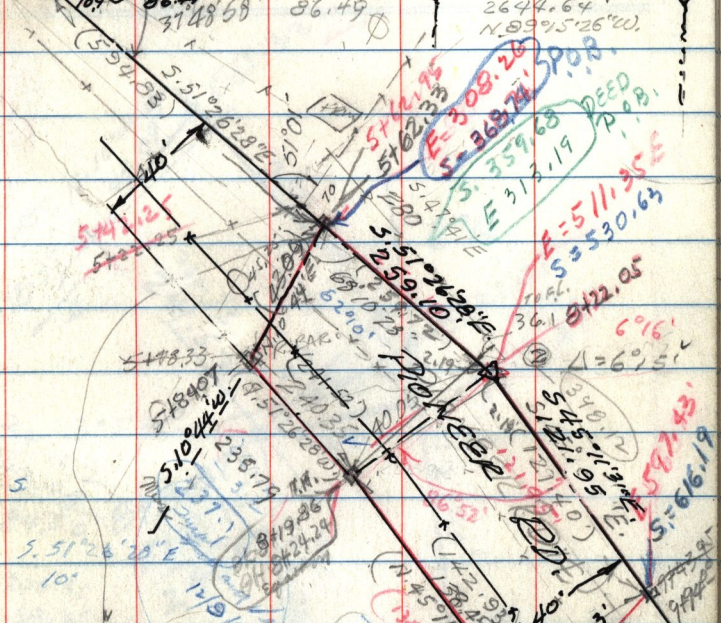


40' R/W

NR 50-52

JACK, NICKIE & FRED
NICE DAY

W. MON.

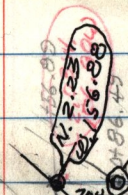

J. TIPPETTS

5.19° 32' W
along FL.
(OLD)

121.40
- 2.19
119.21

see Pg. 53