

N. EAST TO H.A.F. BASE

LT

RT

0+00 Bldg 165 165

2+ LT 227 8.1 RT

4+00

65 23' RT

5+39.43 @

63 23.7

6+00 R. Spk  
nail

26.4 3.9 RT

- 60.47

5+39.53


line

9+

Pl.

29' 20<sup>6</sup>

1+18.

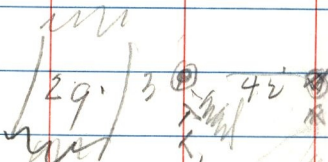

4+46

