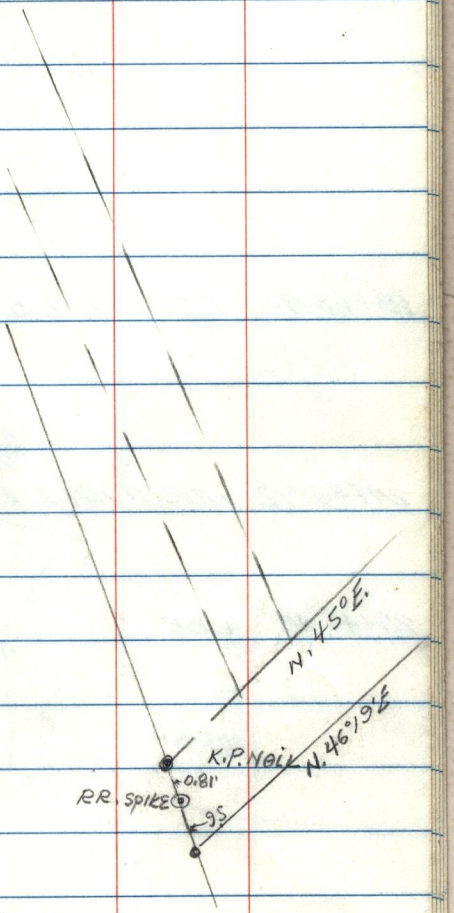
N. 45° E.
N. 46° 19' E.
K.P. Nail
0.81'
R.R. Spike
.95