


MC-51 6 AUG 1980  
J CARVER  
M. HOLMES

(5)

TRAVERSE SO. LINE SEC 21

T7N R1E

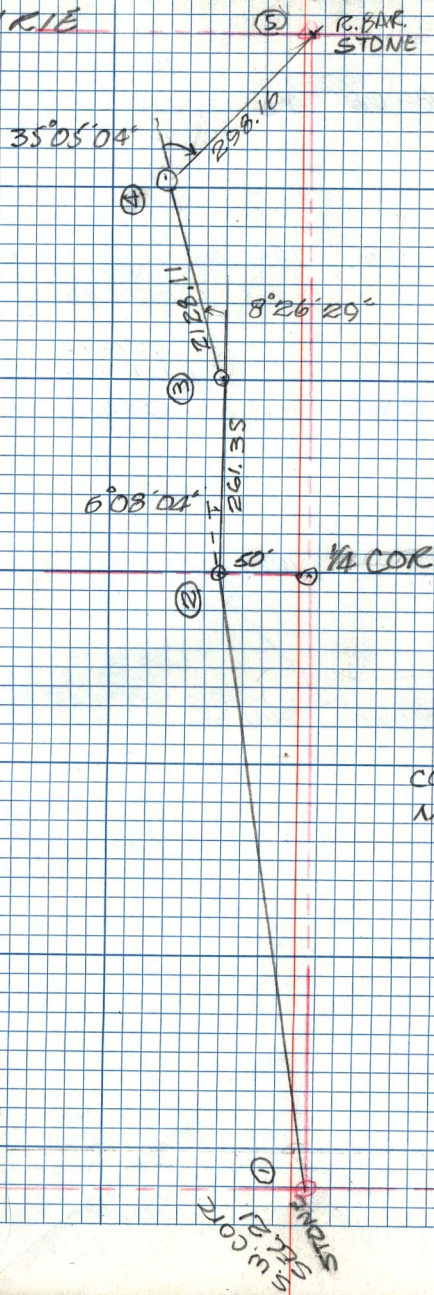

CONTINUED  
NEXT PAGE

1/4 COR  
50'  
1/4 COR