


July 1980 J. CARVER + VERN W. MC-51 (24)

E 1/4 COR. OF S.E. 1/4 SECTION 10 T.5N. R.1W.

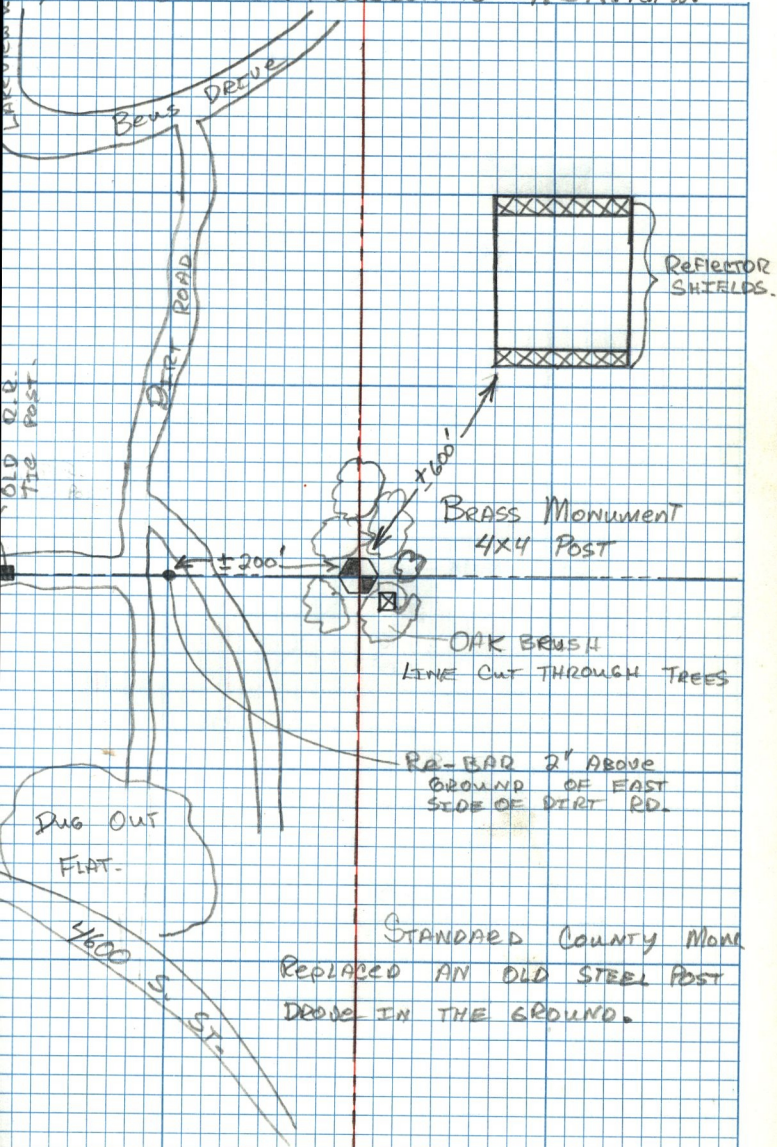

STANDARD COUNTY MON.
REPLACED AN OLD STEEL POST
DRIVE IN THE GROUND.