


WITNESSES FOR CORRS 1,2,3,5,6 3-G-81

T6.7N R3W. F.W.M.J.C. & M.H.

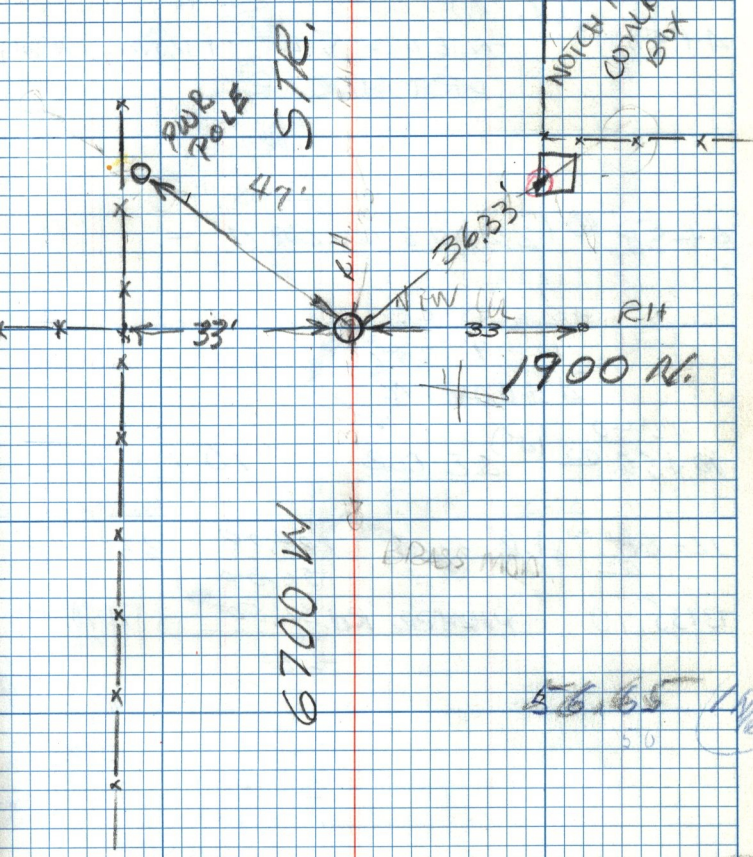

BRASS MARK

56.65 (circled) 50

80.25 (circled) 115 14

80.25 (circled) 115 14 5.54

7000N

67000