


EL 19 TSN RIW.

6 L.O. W.C.
N 11° 5' 19"

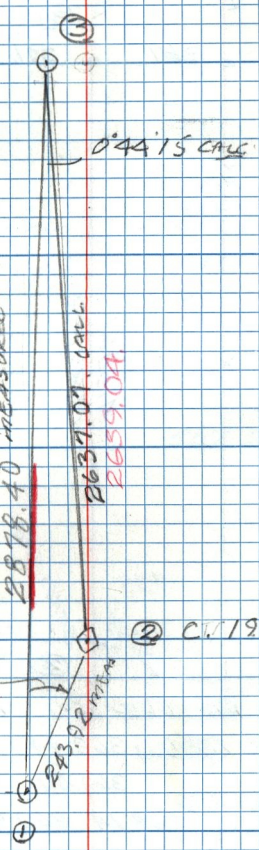

2878.40 MEASURED

2639.07 CALL
2659.04

0°44'15" CALL

② CW 19

8'00"

H.T.