

MC-51


10 APR. 81  
J CARVER  
MILWAUKEE

(32)

ROSE HILL SUBDIVISION

T6N2W

E.S.4

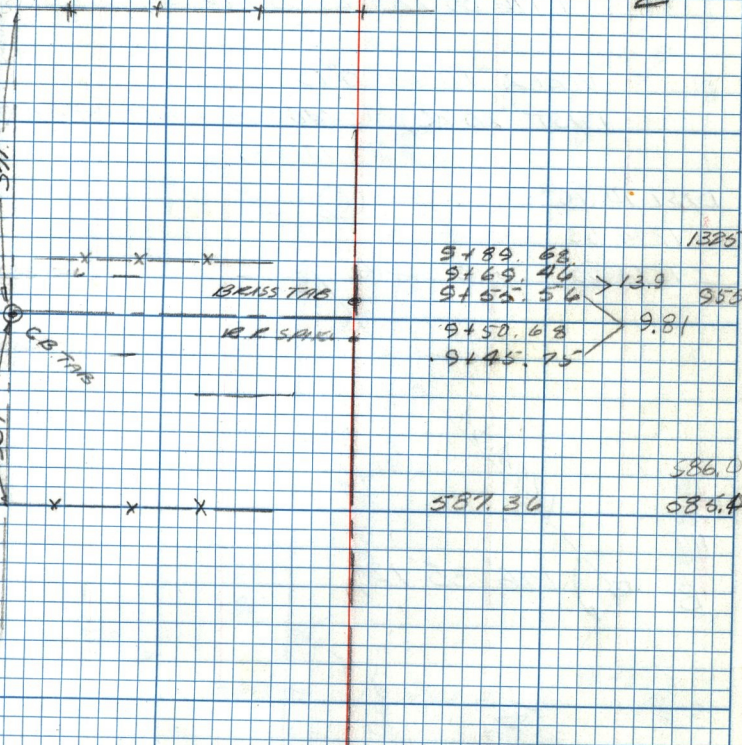

- 955.08
- 07
- 12
- 12
- 13
- 14
- 17
- .34
- .33
- .34 AVE .37
- .39
- .40
- .35
- .38

PIONEER RD.

0+00  
 W. 1/4 S. 4  
 1320.06, 14, 06, 07  
 1320.00, 06, 15, 16,  
 1320.10 AVE