MC-51

14 APR. 81
J. CARVER
in HOLMES

(33)

OSE HILL SUBDIVISION

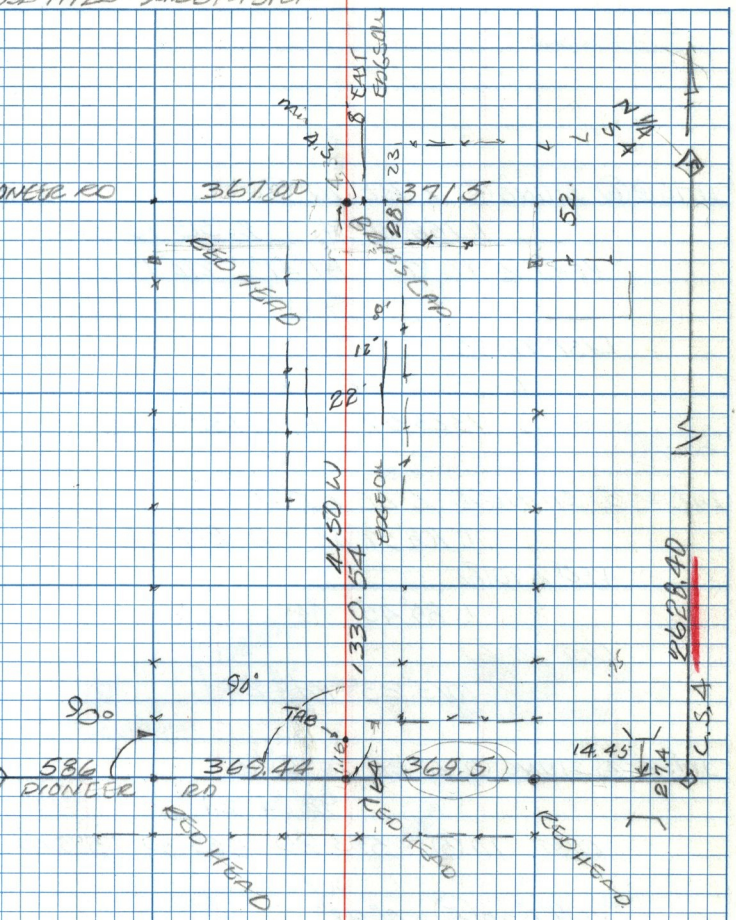

ints @ C 4 EAST TO N ¼

1. 2628.45' 2. 2628.43 3. 2628.47

VERT ∠ = 0°17'