


MC-51

5 JUN 81
J. CARVER
D. HAWKES

(36)

T5N R2W SEL 7.

CONTINUED P. 39

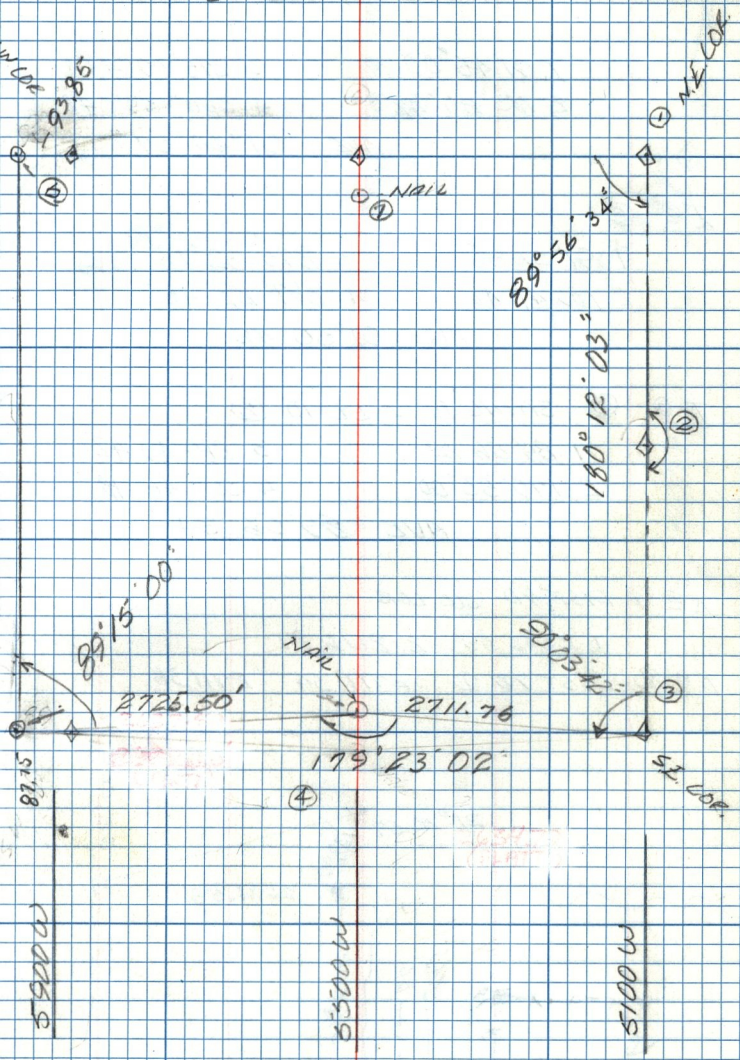

(OVER)