


MC-51

22 JUN 81
J CARVER
M HOLMES
D HAWKES

(41)

SEL 14. T5N R3W

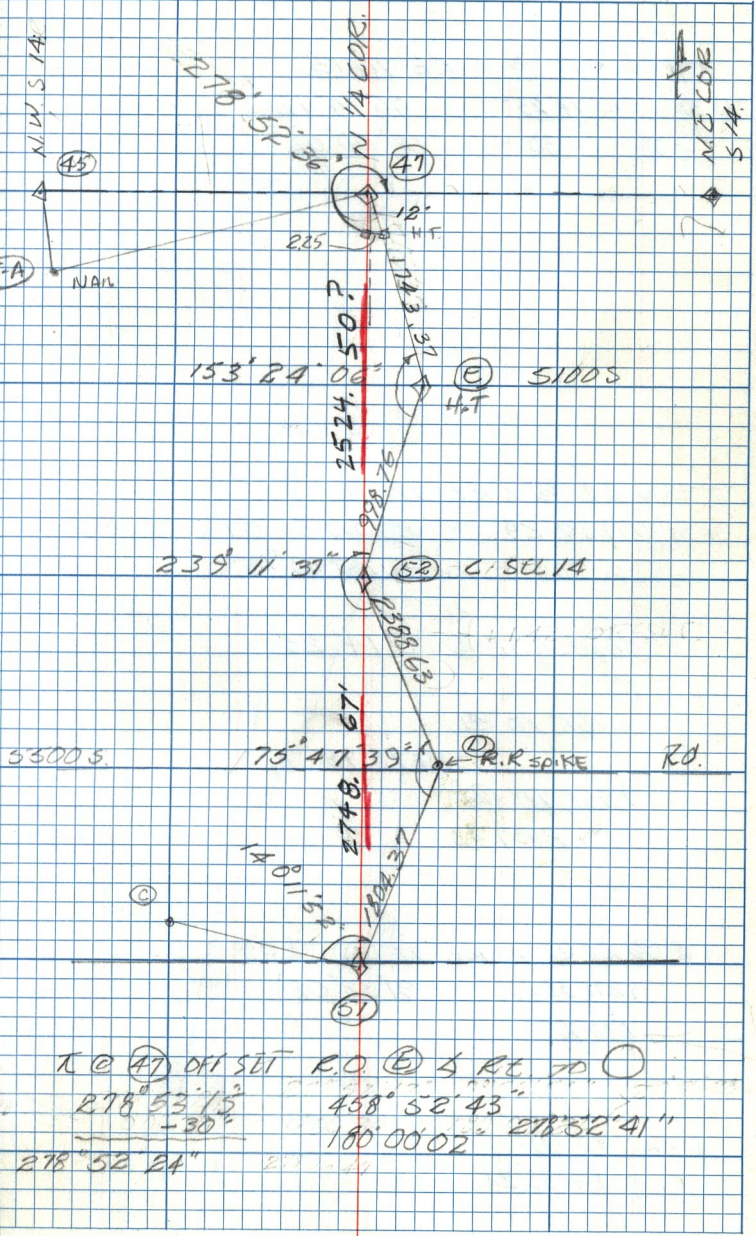

$\pi @ (41)$ OFF SET R.O. (53) & RE TO (51)
 $278^{\circ} 52' 24''$ $458^{\circ} 52' 43''$
 $-30''$ $180^{\circ} 00' 02''$ $278^{\circ} 52' 41''$

$278^{\circ} 52' 24''$