


1/4 COR OF 12, 7 T5N R23 W

11 JUN 8  
J CARVER  
M HOLME  
P HOWE

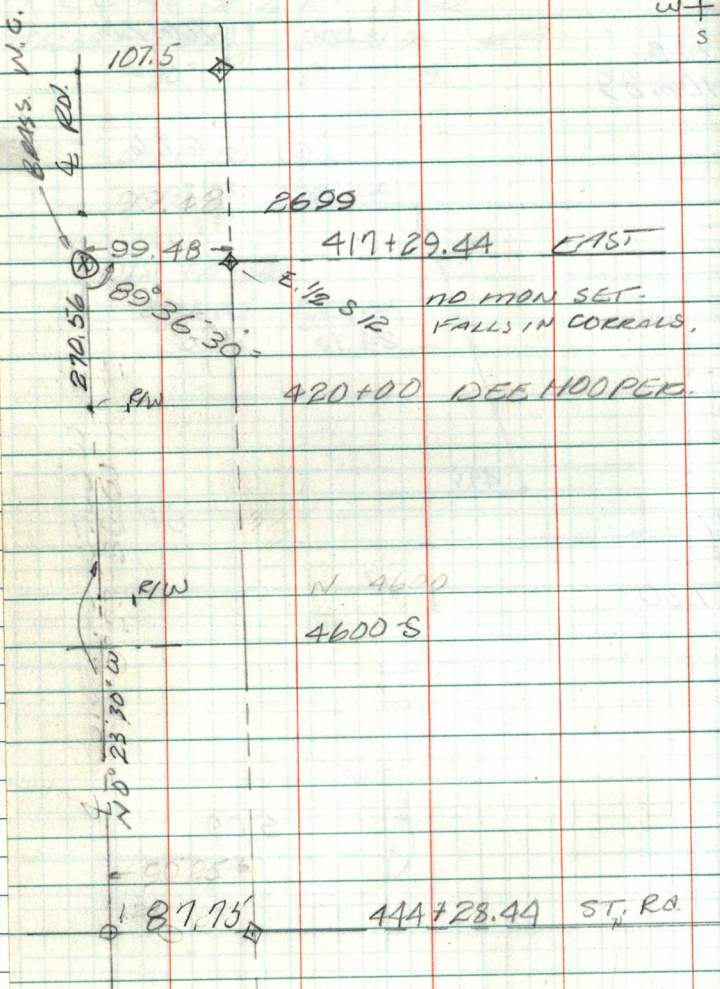

NO MON SET.  
FALLS IN CORRALS.

N. 4600  
4600 S

444+28.44 ST. RD.