


MC-51

14 SEP. 81
J. CARVER
M. HOWES

(49)

T5 = 6 N KRW. SEC 1 = 36

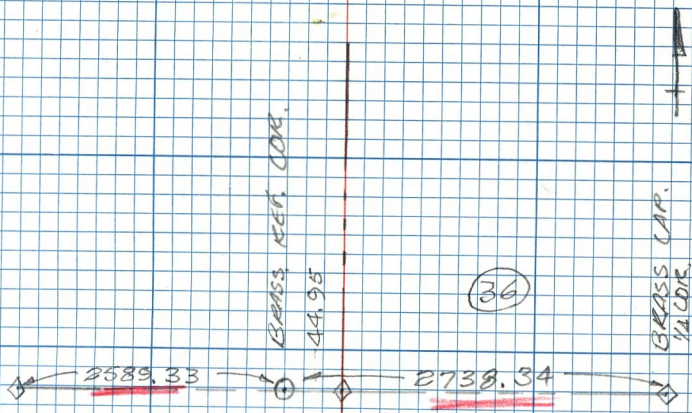

BRASS REF. COR.

44.95

(36)

BRASS CAP.
1/2 COR.

(1)