


MC-51

16 SEPT 81
J. CARVER
M. HOLMES
D. HAWKES.

(50)

T6N R2W S614

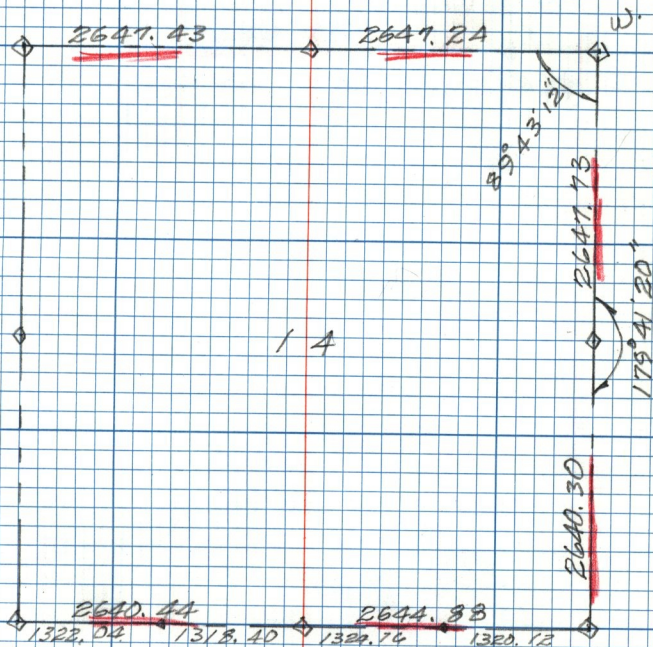

NOTE: ALL CORNERS ARE
BRASS CAPS. FLUSH
WITH RD. SURFACE
OR BELOW.