


T7N R1E 36L 17

MC-51

19 SEPT 81  
J. CARVER  
M. HOUTES  
D. HAWKES

(53)

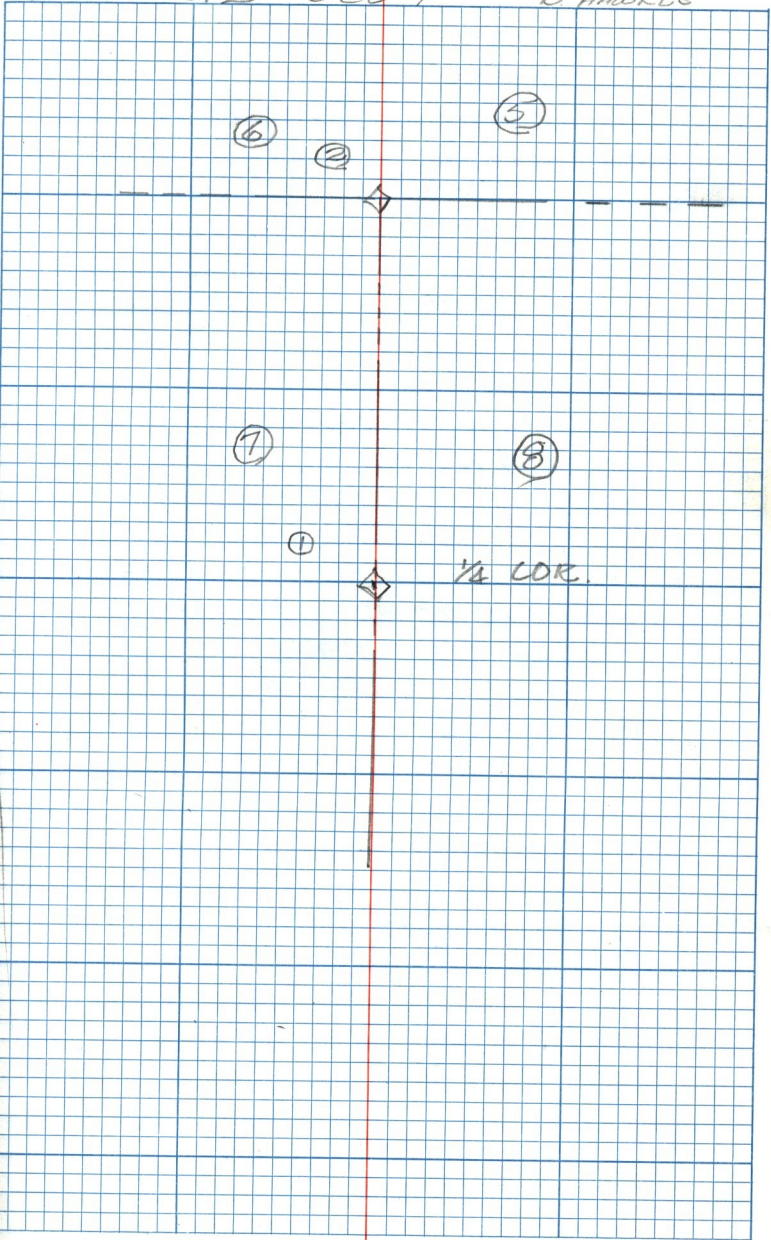

1/4 COR.