


MC-51

9 OCT 81
J. CARVER

(65)

T6E7N R2W SEC 3, 4, 33, 34. M. HOLMES

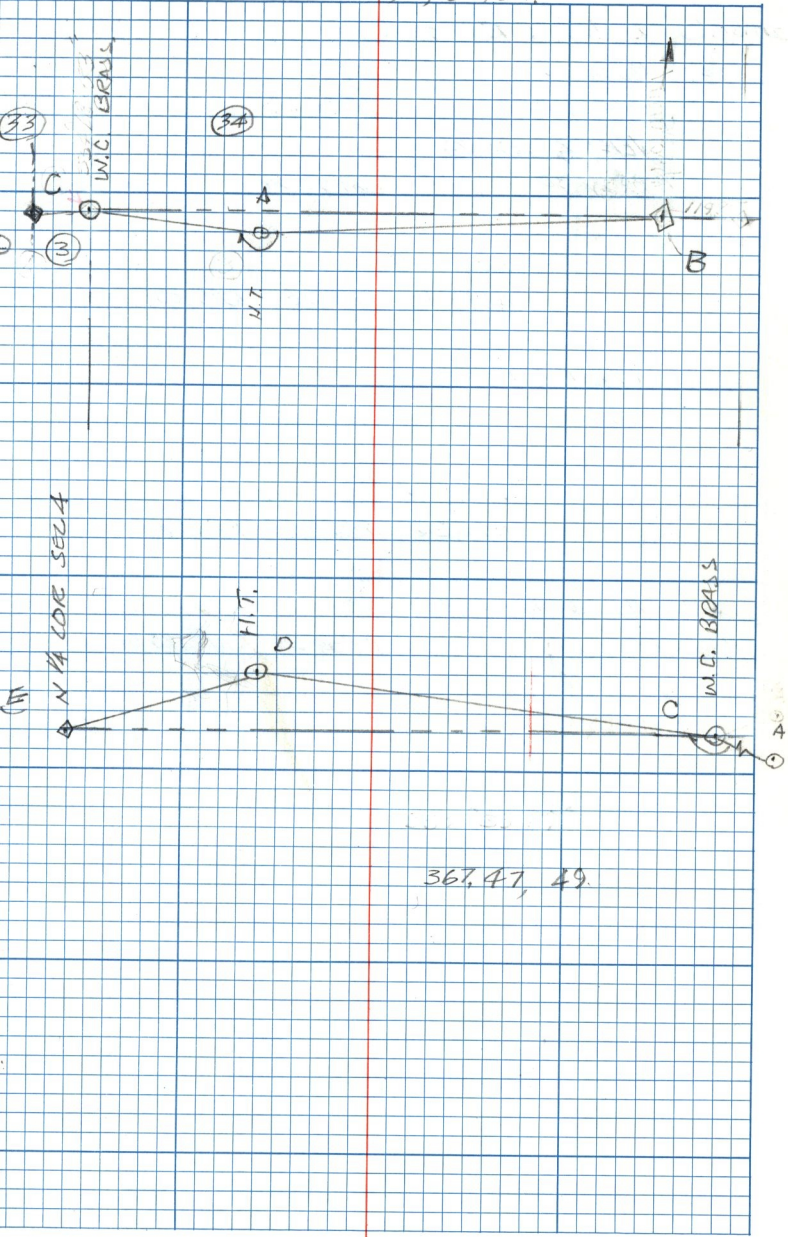

36, 47, 49