


T5N R1W

#405

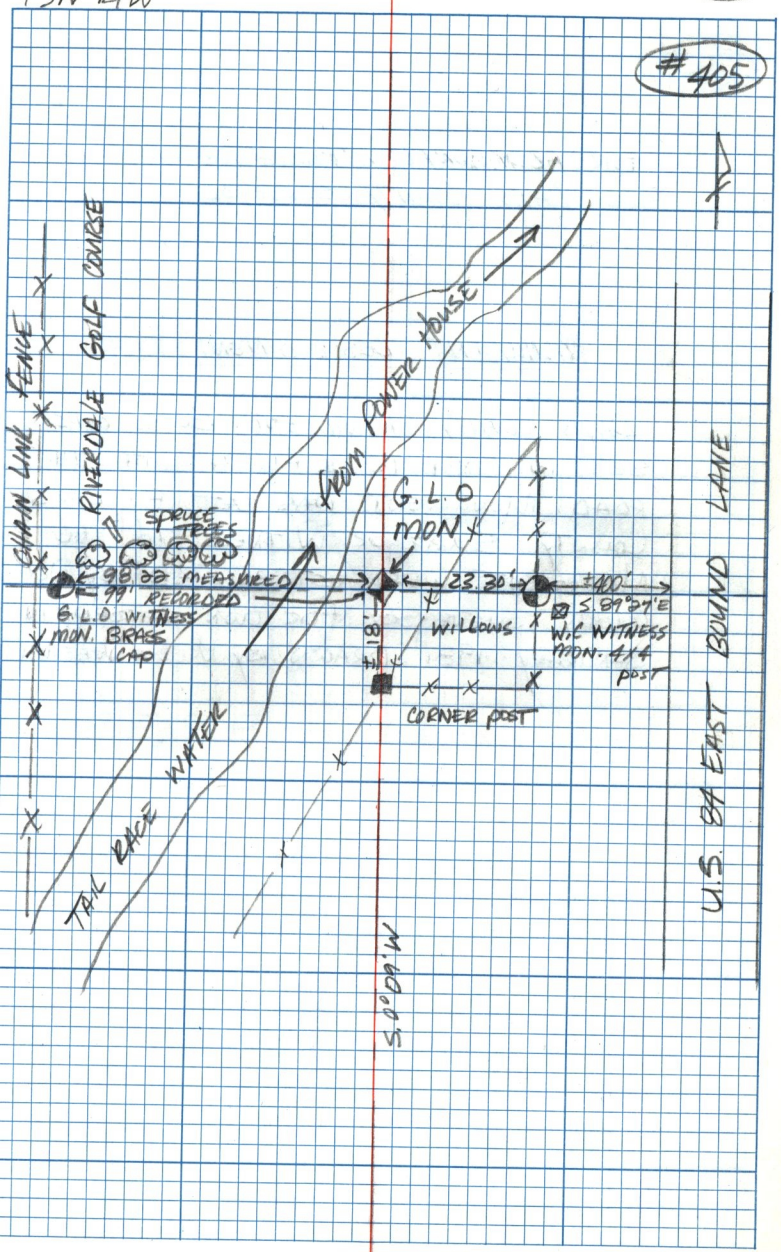

CHAIN LINE FENCE

RIVERDALE GOLF COURSE

SPRUCE TREES

POWER HOUSE

G.L.O. MON.

U.S. 8 1/2 EAST BOUND LANE

98.00 MEASURED

99' RECORDED

23.30'

G.L.O. WITNESS MON. BRASS CAP

S. 89° 04' E W.I.E. WITNESS MON. 4x4 POST

CORNER POST

S. 0° 0' 0" W

TALE RACE WATER

WILLOWS