MC-52

23 OCT 81
J. CARVER
M. HOLMES

①
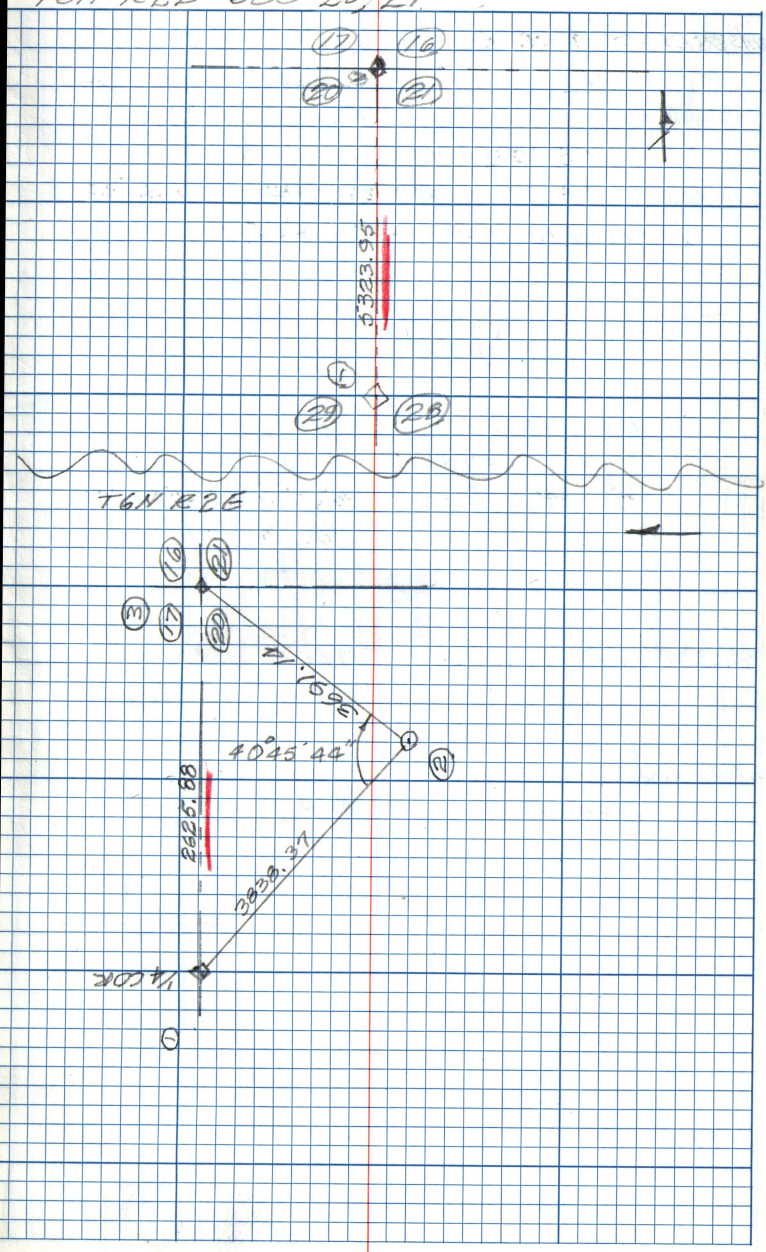
T6N R2E SEC 20, 21