


MC-52

19 NOV 81
J CARVER (3)
M. HOLMES

TTN 122W SEG 3A

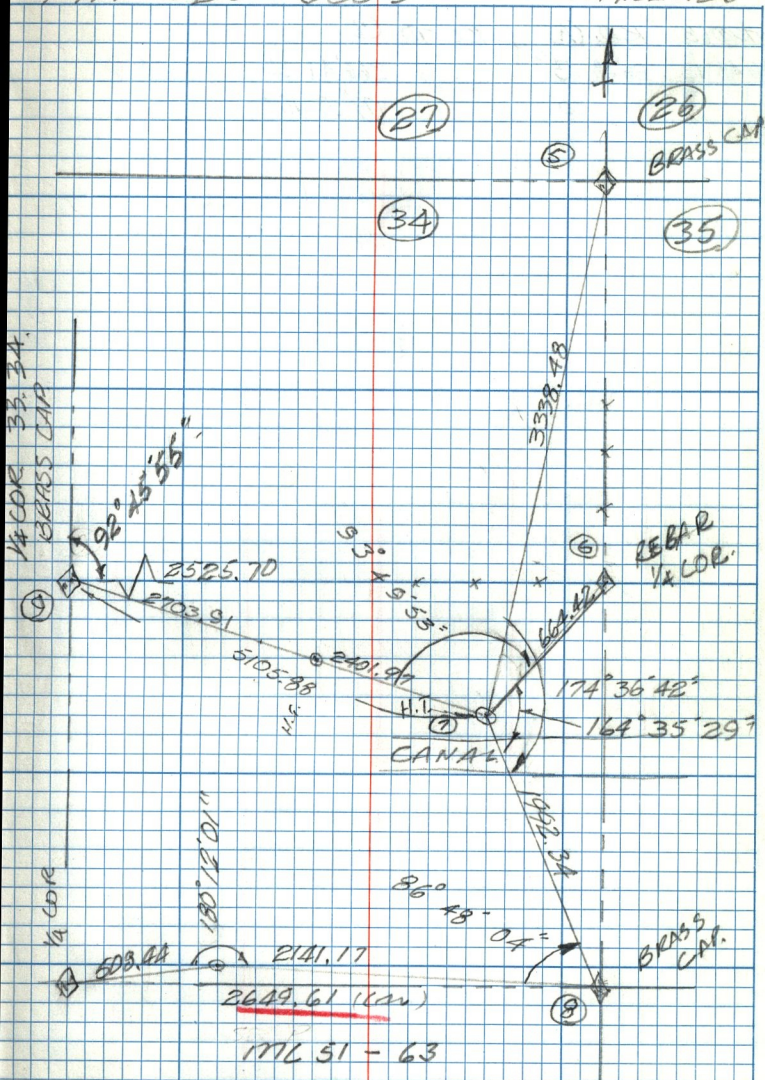

2402.03 2401.98 2401.94 2401.98 2401.99 AU-2401.97