

MC-52

11 DEC 81


J. CARVER

(12)

T7NRIE SEL 34 & 35

M. HOLMES

#427

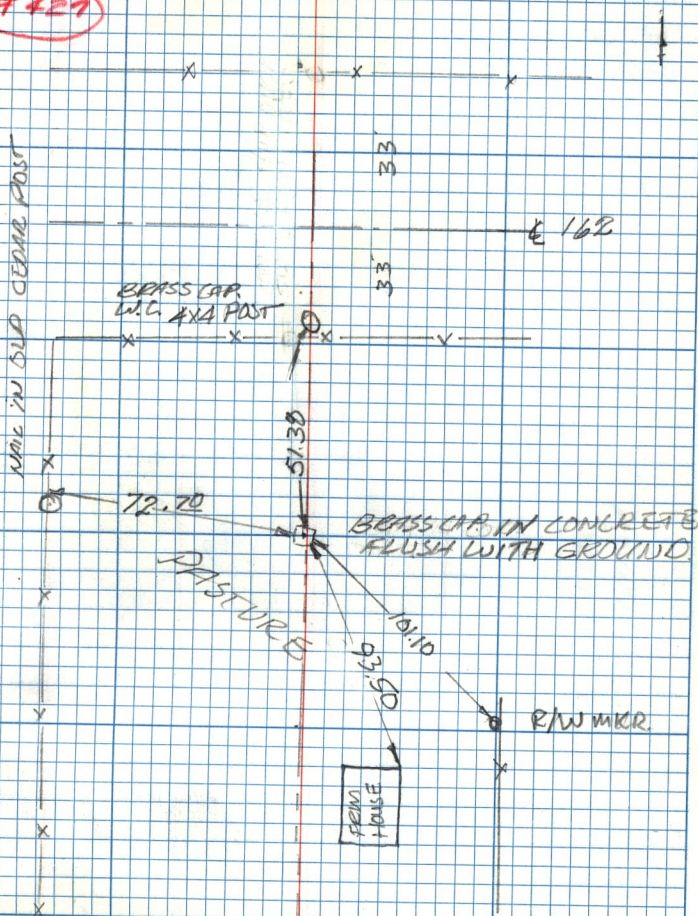

1/4 CORNER SET BY PROP
 MEASUREMENT, 1981
 ORIGINAL STONE INT.
 MOVED. YEARS AGO.