


MC-52

JUNE 81  
M. HOLMES  
D. HAWKES

(19)

#70

TGN RW

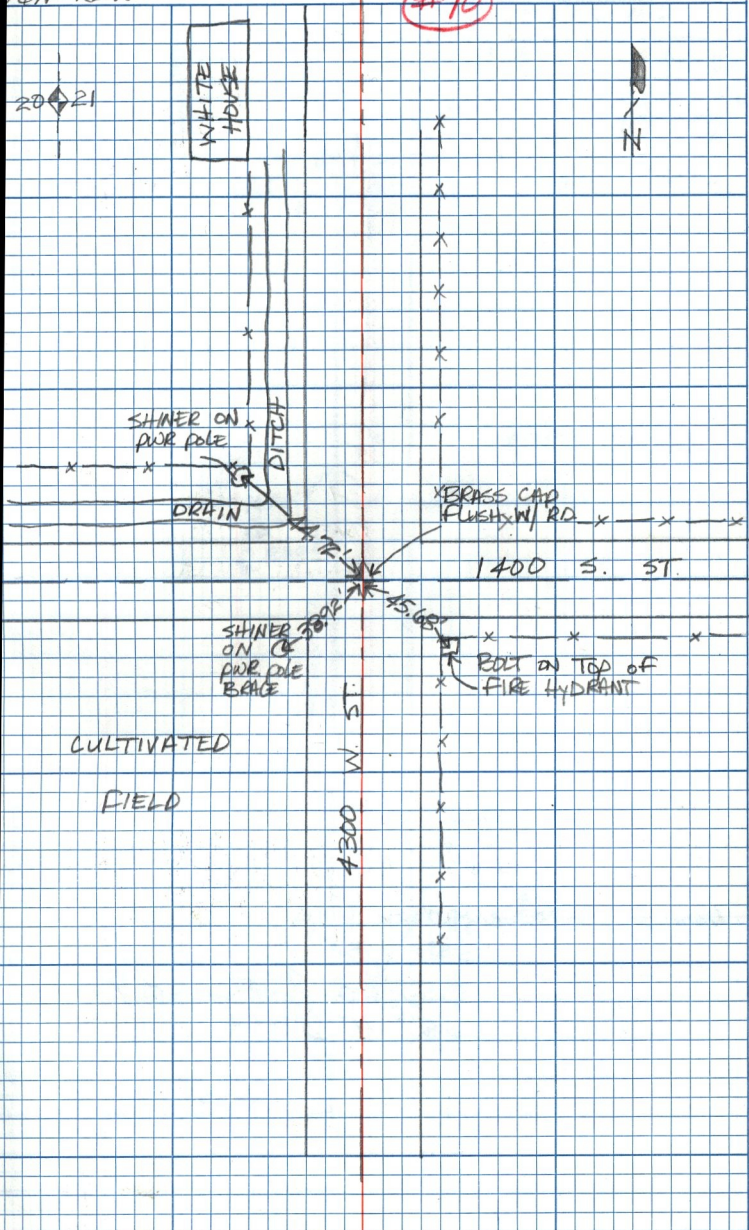

RD 20 21

WHITE HOUSE



SHINER ON PWR POLE

DITCH

DRAIN

BRASS CAP FLUSH W/ RD.

1400 S. ST.

SHINER ON PWR. DIE BRACE

45.65

BOLT ON TOP OF FIRE HYDRANT

CULTIVATED

FIELD

4300 W. ST.