


CLEAR 68°

MC-52

26, Apr. 82
B. Hillier
M. Holmes

(28)

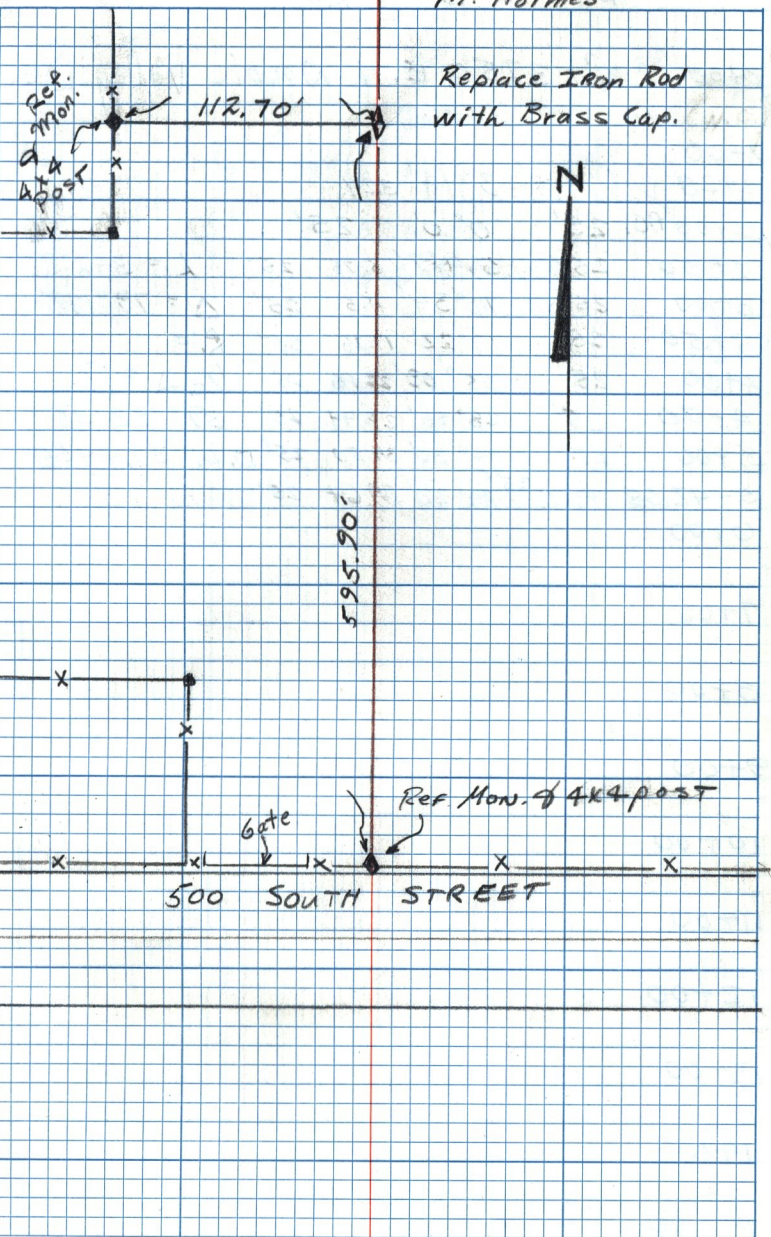

Replace IRON Rod
with Brass Cap.

Ref. Mon.
4x4 post

Ref Mon. of 4x4 post

500 SOUTH STREET