


MC-52
May 24 '82

T. T. N. R 2 W. B. Hillier
M. Holmes

(56)

Sec. 13 J. L. S.

V. Warner N

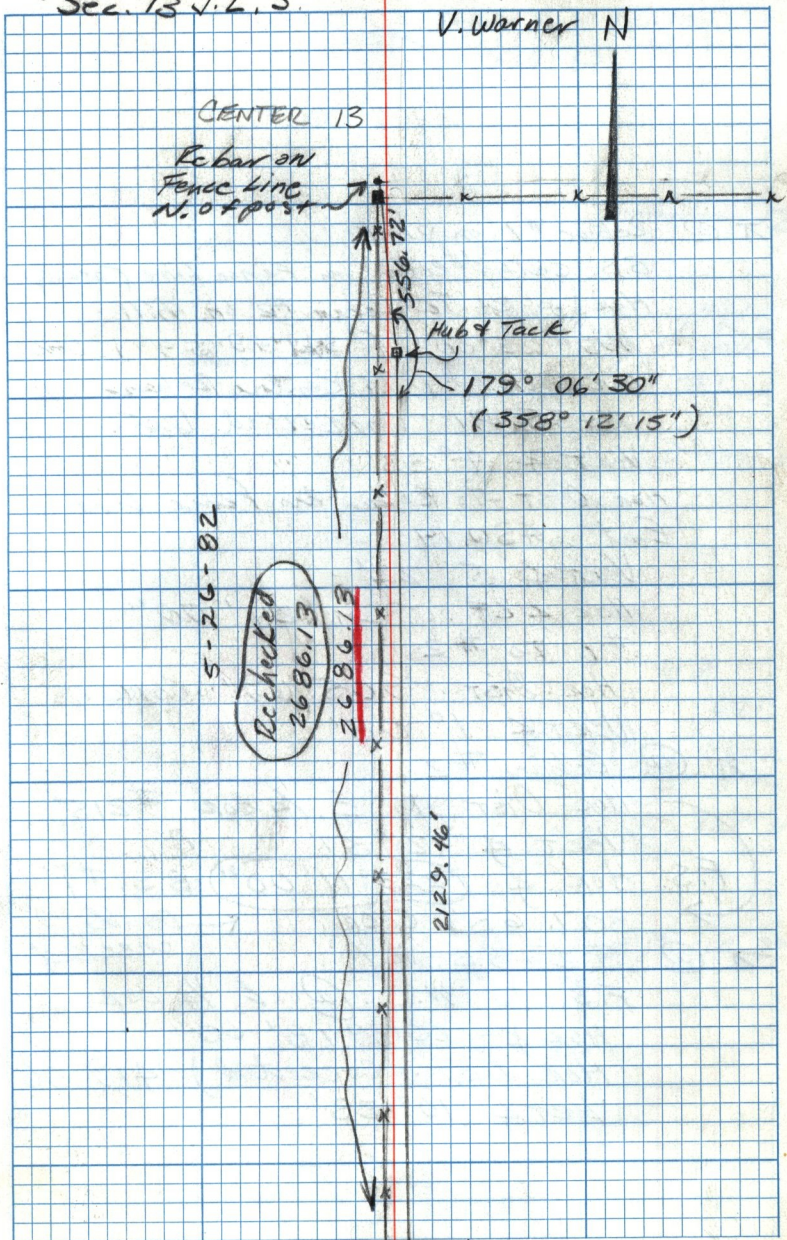

CENTER 13

Rebar on
Fence Line
N. of post

556.72'

Hub & Tack

$179^{\circ} 06' 30''$
(358° 12' 15')

5-26-82

Rechecked
2686.13

2686.13

2129.46'

S 1/4