


MC 52
T7N. R2W.
May 27 '82

M. Holmes

Jerry Larsen
survey

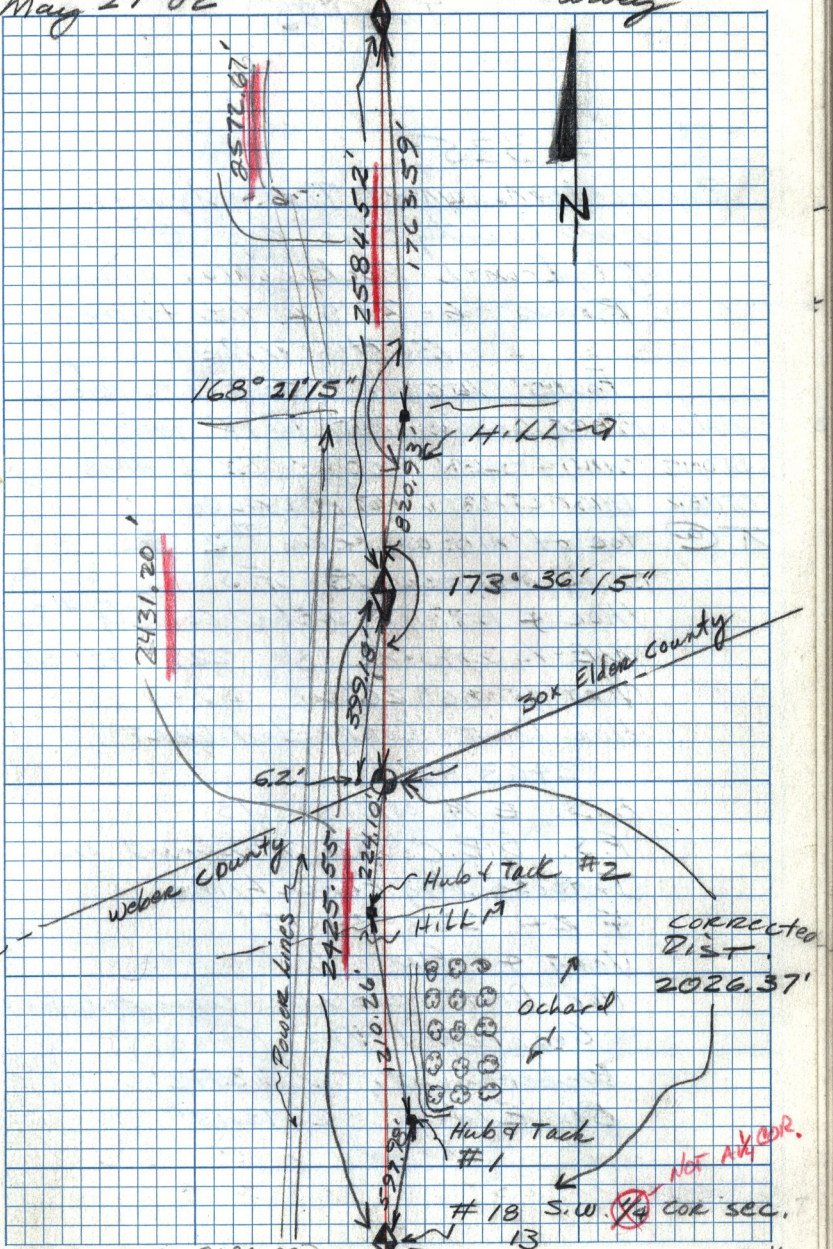

SLOPE DISTANCE 2696.98 }
 VERTICAL $\angle 8^\circ 40'$ } 2666.19'

2666.19' → S_{K1} Cor.