LIVESTOCK (WEBER COUNTY PROP. TO KEITH ANDERSON) HILLIER HOLMES WARNER 9-16-82 12

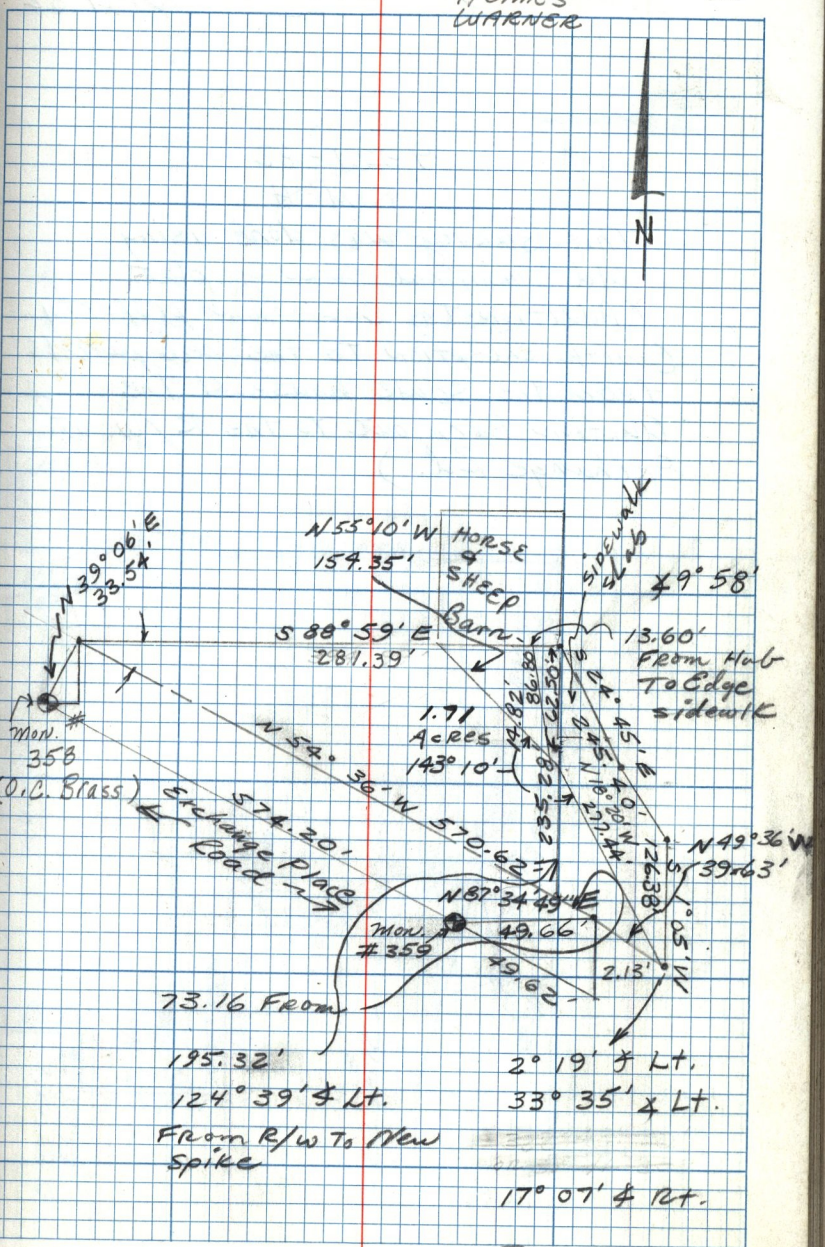

cont Page 13