


WEBER COUNTY PROPERTY, WEST OF COURSE 16
 AUCTION, YARD, BARN, OFFICE & SCALE AREA

10/25/82
 11-6-82

FRED MALAN
 VERN WARNER

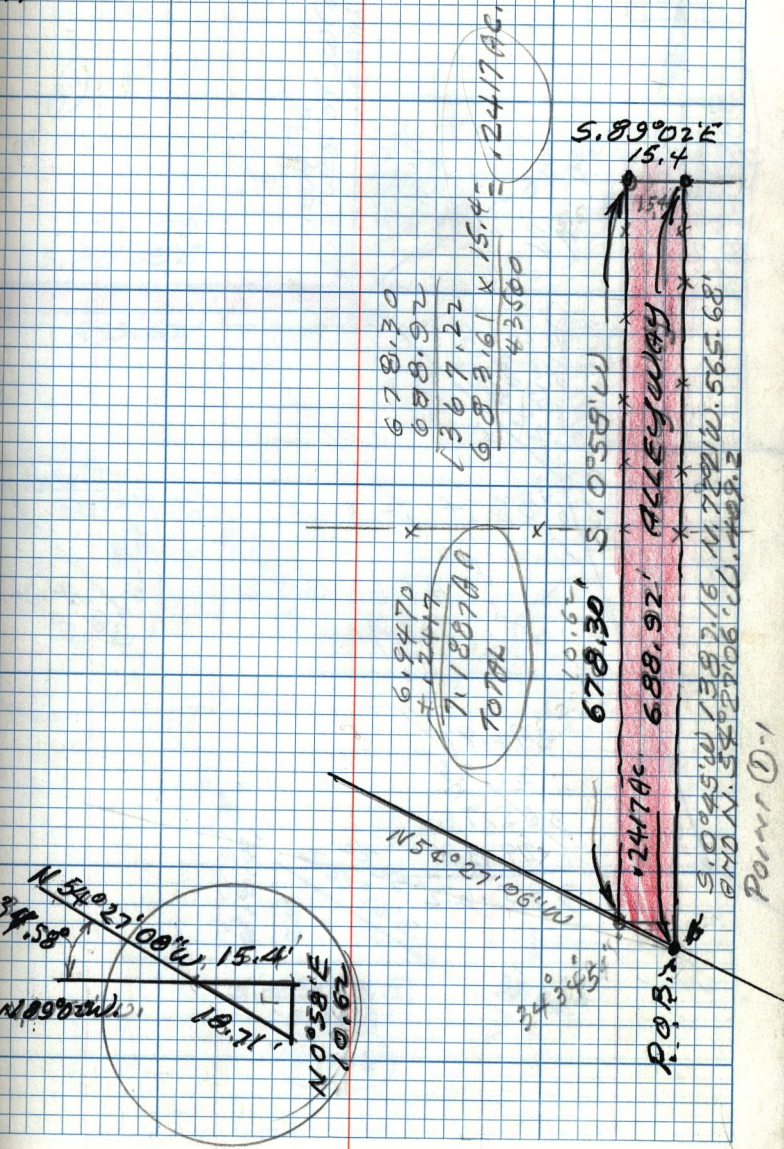

678.30
 088.92
 1369.22
 683.61 x 15.4 = 12417 AC.

6194.70
 + 12417
 71887.80
 TOTAL


S. 89° 02' E
 15.4

10.61
 678.30 S. 0° 55' W

ALLEYWAY

1387.16 N. 78° 10' W. 565.68'
 END N. 54° 27' 06" W. 1068.2

Point 1-1

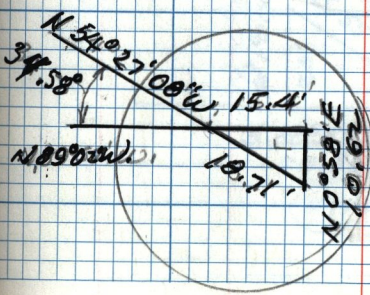

N 54° 27' 06" W

34.58

P.O.B.