Exchange Building Dimensions
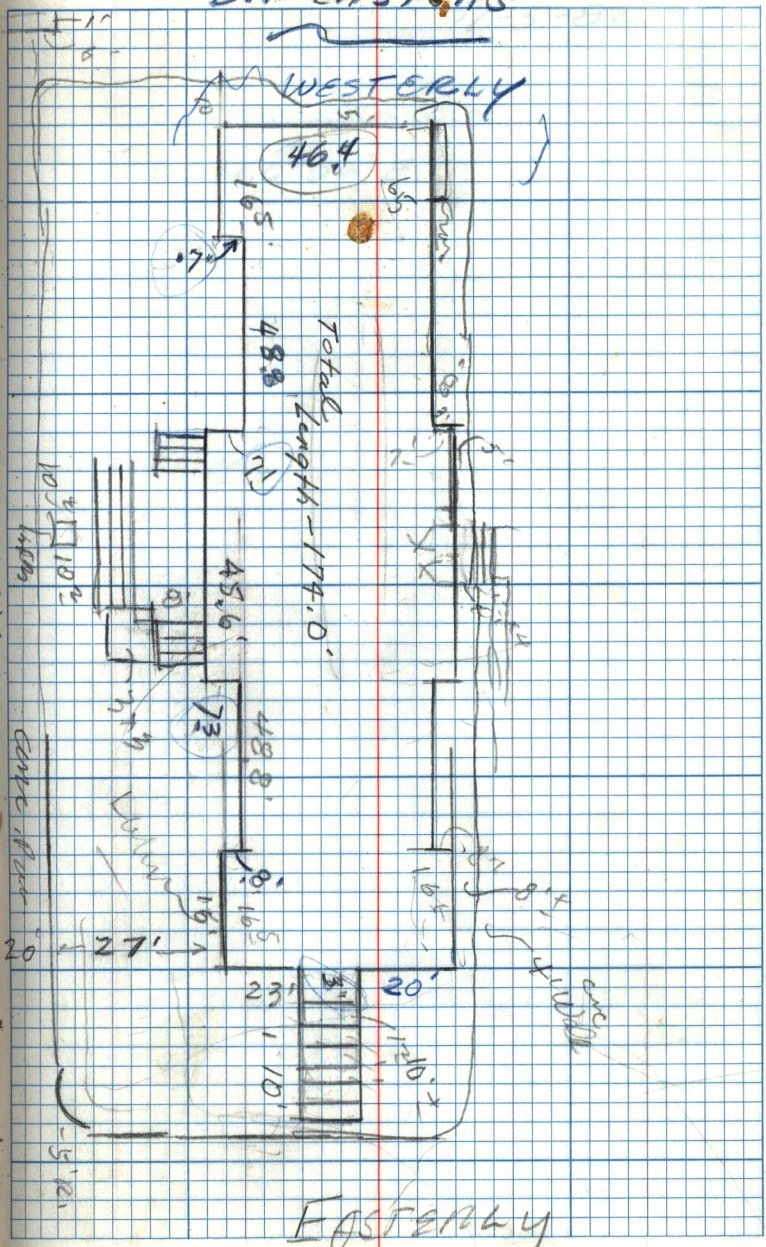
MC53-19