

Dec. 22 '82 Exchange Bldg. Measurements

Dimensions on 20' R/W of Exchange Bldg. & Strip Between Barn

Corral Fence Ties To Exchange Rd. R/W

(281.89')


(12.29.82) Point #2

True Corner 1' East of 1'.18"

SOUTH of Ref. Rebar in cement

(Description #2)

Scale House Measurements

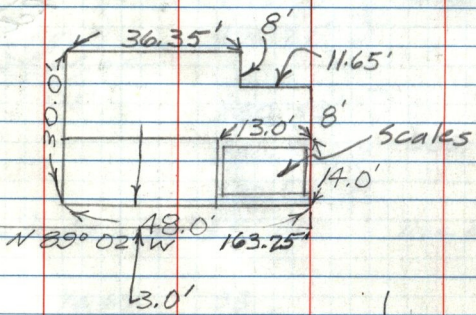

Corral Fence Ties to Rd. R/W

