MC53-30

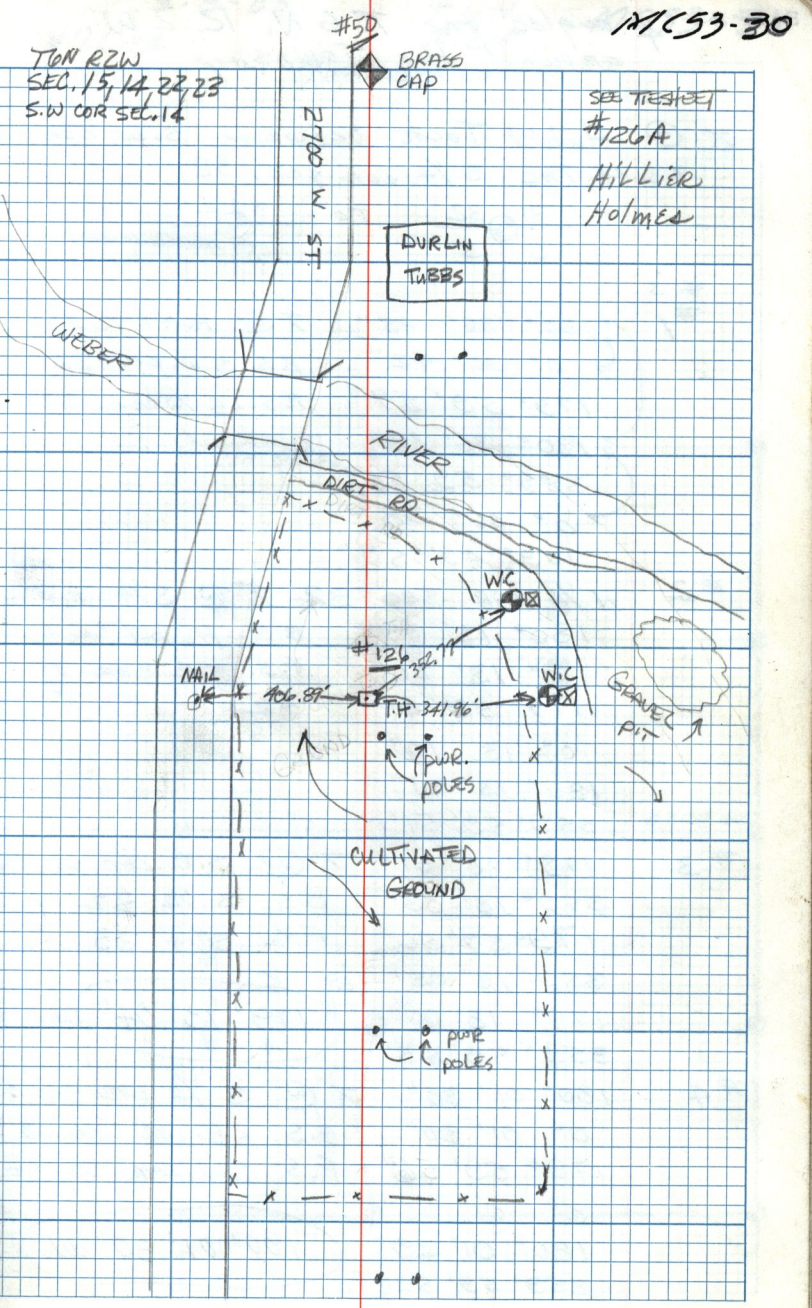
T6N R2W
SEC. 15, 14, 22, 23
S.W COR SEC. 14
#5D
BRASS CAP
SEE TIESHEET #126A
MILLER HOLMES
2700 W. ST.
DURLIN TUBBS
WEBER
RIVER
DIRT RD.
WC
#126
NAIL
406.89'
T.H 341.96'
W.C
GRAVEL PIT
PWR. POLES
CULTIVATED GROUND
PWR POLES