

5-3-83


T @ $89^{\circ} 57' 17''$

N.W. $179^{\circ} 54' 35''$

cor. sec. 28

Lietz total station

Williford
HILLIER Butlers

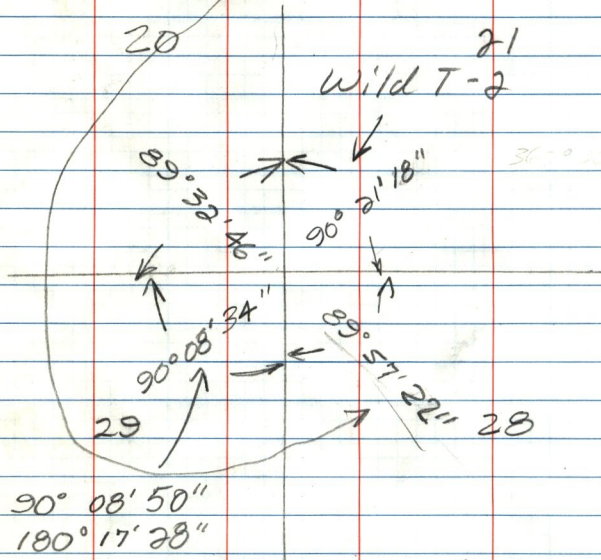

Lietz total station

2,643.28

2,643.28

2,643.31