

Little Mtn. Property Air Force To T. 6 N,
Weber County R. 3 W.
Q. R. 4 W.

11-01-82 Mile Dist Check
on RR. R/W along 100' R/W
on Bearing $95^{\circ} 54' 05''$ East
5273.44

on 250' R/W $84^{\circ} 05' 55''$ West
5277.76

Hor. & Lt. B.S. Sec. Line N. & S. sec. 24
F.S. $86^{\circ} 58'$ To $\&$ OF S.P.R.R.

Hor. & Lt. B.S. pt. on sec. line π @
50' WEST N/S sec. line F.S. Lt. $93^{\circ} 02'$
To pt. 50' OFF fence 820'


π @ sec. cor. $\frac{13}{18}$ Hor. Dist. To
 $\&$ OF S.P.R.R. $\frac{24}{19}$

Computed Dist. 2541.88'

VERT $\&$ $93^{\circ} 05'$ & $94^{\circ} 13'$

Legal Description DIST. TO R/W
OF S.P.R.R. 2430' CAME 111.88'

BL FROM R/W & set Hub & Tack.

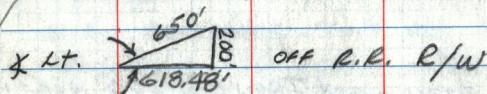

$17^{\circ} 55'$ Recomputed to R/W 200'

(DISTANCES set at 250' & 100'
off S.P.R.R. $\&$)

132.85' DISTANCE From the Hub &
Tack 111.88' From S.P.R.R. $\&$ To
the point 250' From $\&$ 50' WEST
OF section line fence.

244.73 (shift 5.27 NORTH
FOR R/W) 10-21-82