10-7-82
Rainy
Little Mtn. Survey

T, 6N. R4W. Hillier
Holmes
Floyd

(8)
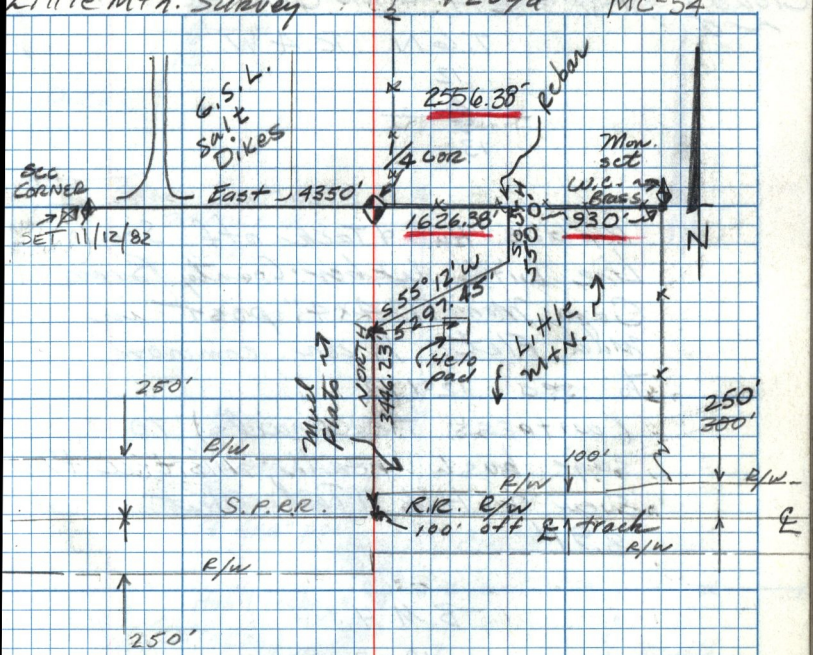
MC-54