

FARR WEST  
City


T. 6 N. R. 2 W.

Dec. 15 82

Sec. 12

N. 1/4 COR. & Center of  
section

I-15

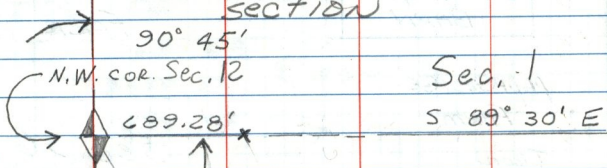

Sec. 1

S 89° 30' E

Sec. 12

FARR WEST STAKE PROP.  
SURPLUS & SCHOOL DIST  
OF 8' ON SEC. LINE

974.82

1951.44

589.6

387.02

11.44 ch. = 755.04

HOR. DIST. OF 5313.95'

1.75 chains = 115.5' BK FROM PROP

SECTION LINE

5313.89' }  
 5313.88' } 5313.95'  
 5314.01 }  
 33.95'

I should be 206.' TO Chain Link fence  
227.0' FROM EAST R/W ON 1200 W. TO  
PROP. CORNER EAST

373.5 + 206.5 = 580.0'

TO SEC. LINE (EAST LINE OF SEC. 12)