



T. 6 N. R. 2 W. MC-24
R.R. Sec 14 & Sec. 23. HILLIER (35)
Wit. mon. #126 Holmes Sunny

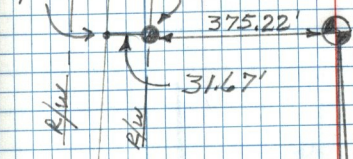

S.W. Cor. Sec. 14.

(N 0° 51' 19" E)
computed

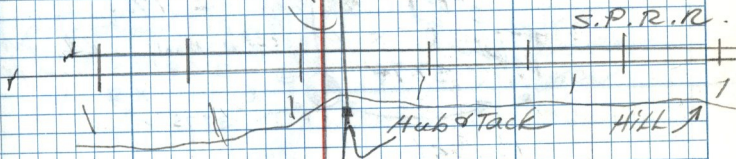

(2635.84')
computed

W 1/4 cor. sec. 23.
#59