

MC-54


HILTIEN
Holmes

T. 6 N. R. 2 W.
sec. 17
S.W. cor.

(36)

CLEAR
55'

#160

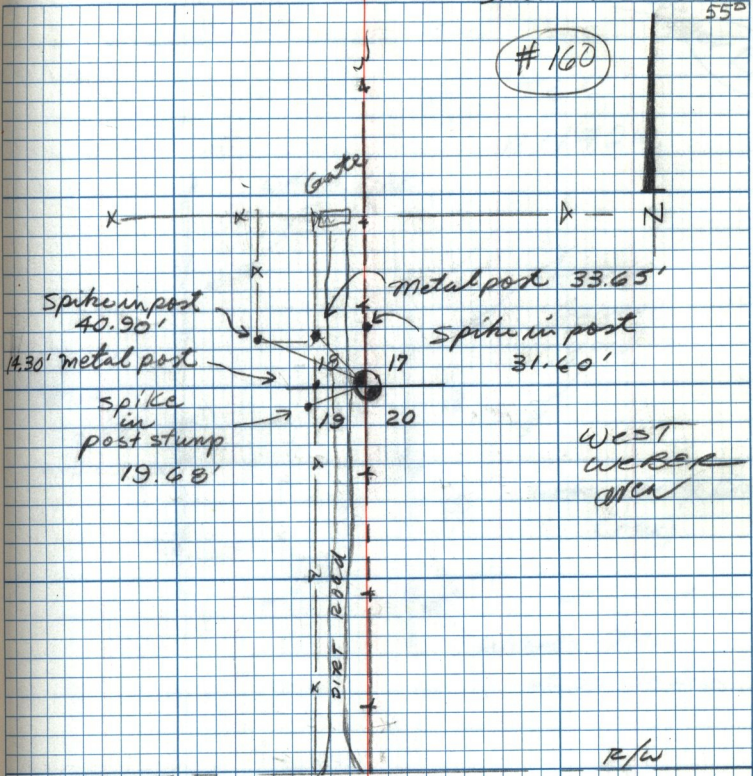

WEST
WEBER
etc

R/W
900 So.

R/W

5100 west