9-30-82 (31)

Hillier & Holmes

Weber River
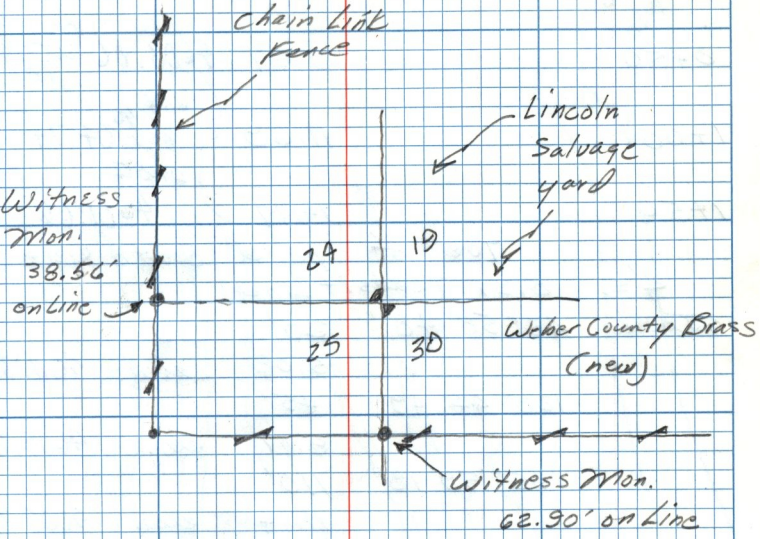
T. 6 N.
R. 1 W.