
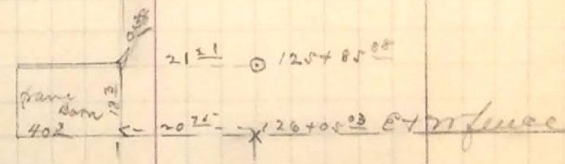



1

1


01

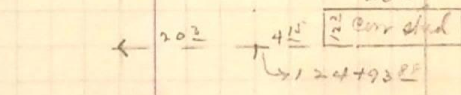

6

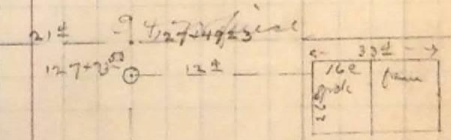

8

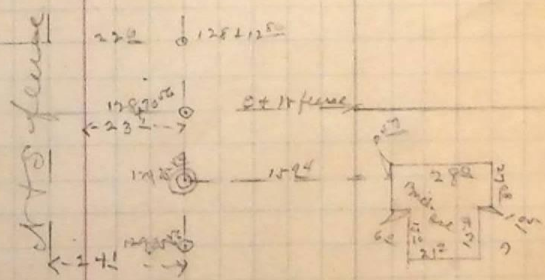

L

