


All Level Book
 # 1 B.
 Page 56

section 24th Grant an
 Sta 114+91 E = S.W. curb with
 Grant an Sta 111+44th West
 Setting Hub^o west curb line
 Saturday Am. April 12th 1900

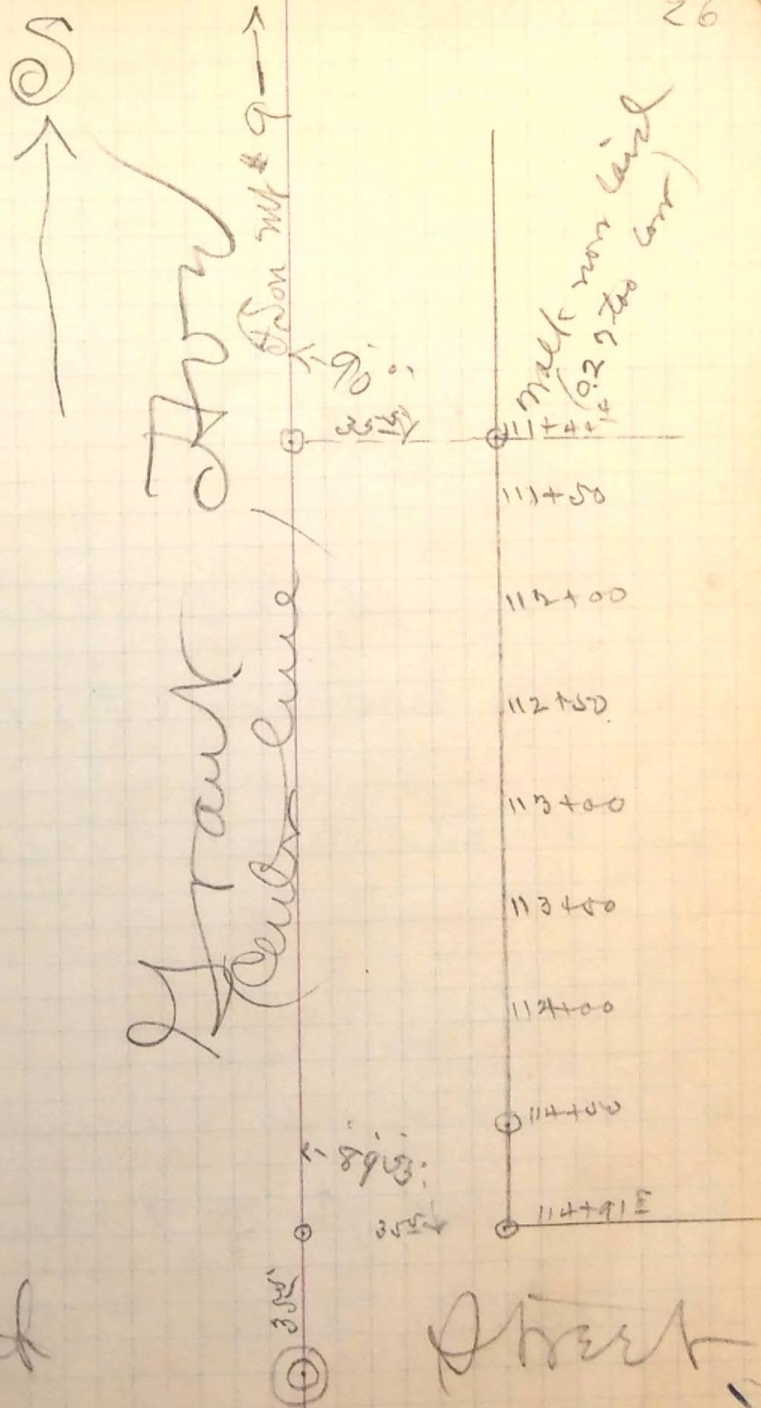

p 2c