

Book Page 18.

for ties to which see Reference

11th St & Washington Ave

afterwards planted Mt # 63

thence checked back exactly  
of Higginbotham Lane

Mt # 2 2nd set Hub for Center  
chained 364.98 South from


Just over Mt # 4 - P.D. on Mt # 2  
Mt # 2)  $\frac{33}{B}$

between Lane by measurement from  
Continued Establishing Center Higginbotham

North Washington Avenue Survey  
Saturday A.M. May 3d 1890

Mt # 63 P.D.

11th St & Washington Ave

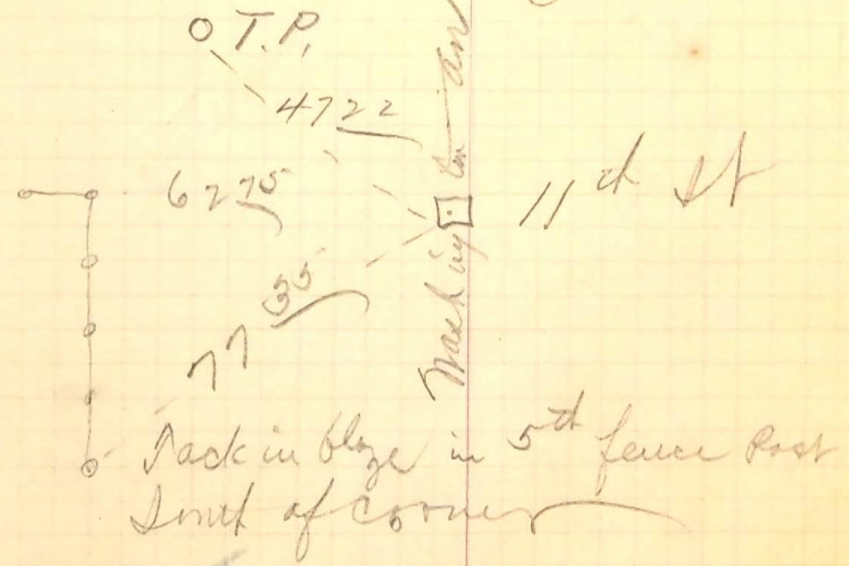

$\frac{33}{B}$