


End of Dump East side West Channel

$$A = 754.00 \text{ cu. ft.}$$

$$C = 1555.00 \text{ " "}$$


$$D = 151.80 \text{ " "}$$

$$\begin{array}{r} \text{(add } 5' \times 25' \times 30') = 375.00 \\ \hline 27 \overline{) 2835.80} \\ 105.03 \end{array} \text{ cu yds Rip Rap.}$$

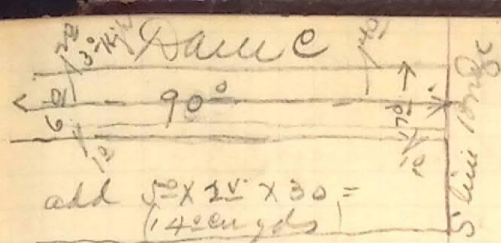

See Page 66

End of Dump East side West Channel

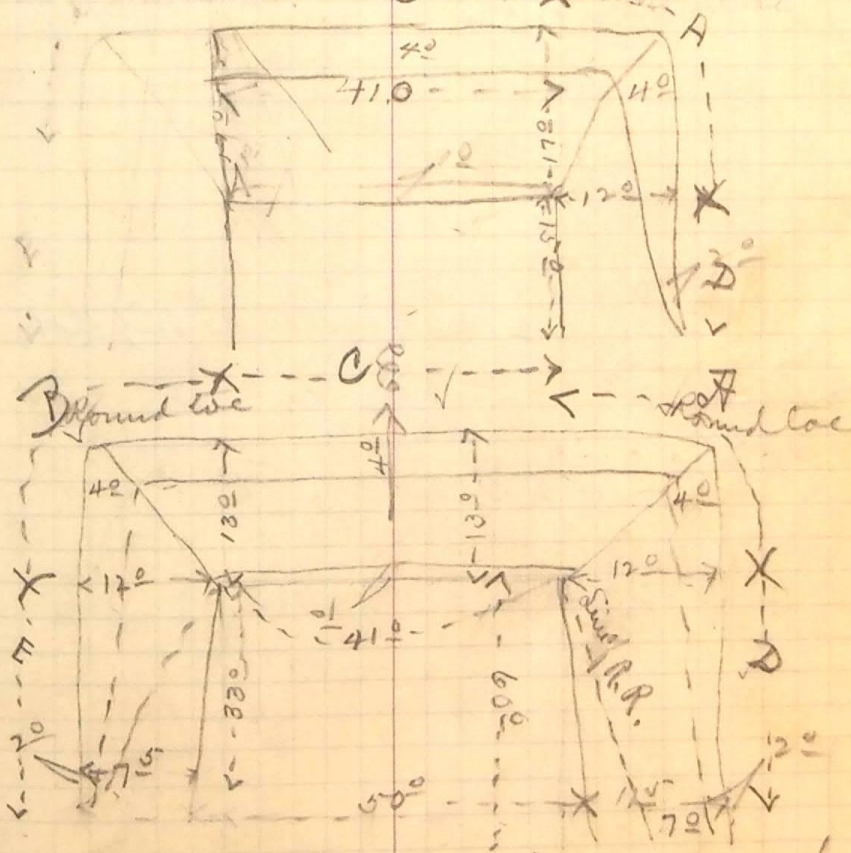

End of dump West side East Channel
Quantities

$$A = 580.58 \text{ cu ft.}$$

$$B = 580.58 \text{ " "}$$

$$C = 725.70 \text{ " "}$$

$$D = 675.00 \text{ " "}$$

$$E = 675.00 \text{ " "}$$

$$\begin{array}{r} 27 \overline{) 3236.86} \\ 119.88 \end{array} \text{ cu yds Rip Rap.}$$

Rip Rap on 30° At Extension
Measurements made to estimate
Tuesday M. May 6th 1870

End of dump West side East Channel