


Page 20' Also to
 See Reference Book
 Am For ties to vertical
 West Center line Washington
 (17th St) 500' offset
 Center Higginsborough Lane
 These planted Mt # 69

around back of 19 South,
 at center 14th St did same but
 0° north B.34
 at 15th St did the same but around back
 90° RT + was at Hub 10° + South 0°
 16th St B.S. on back Center 4° Lane
 These just over Hub center of

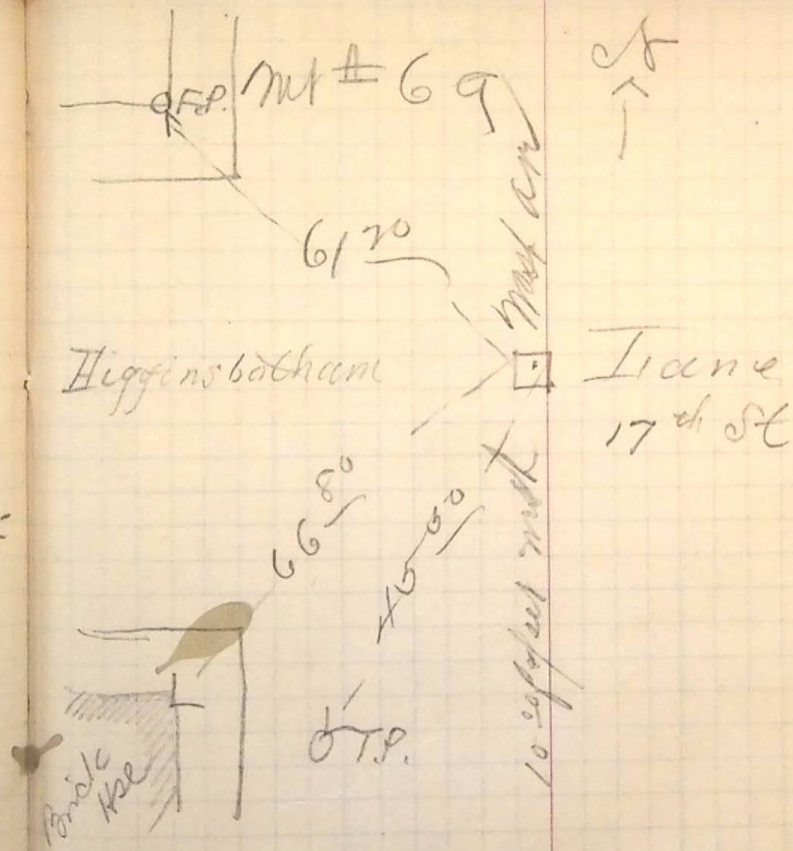

See diagram
 page 69 this book