12703

1790 on page 11 this book

Die correction of total dist bet Mk°

checked readily.

Thence checked back to Wall ans

✗ set Hub 12 71.0 west fm Mk#19

Washington ans double emitted

thence West ans latter Hub B.S.

"Trial" at 1195 ± Stuck Hub.

Thence chained fm Wall ans

sly track

ft East of east rail to most west-

ward ✗ set Hub. about +2

Mk#62 ± ✗ Washington double

Dist ans Mk#1 track ± 38th B.S. in

Transit

B 34

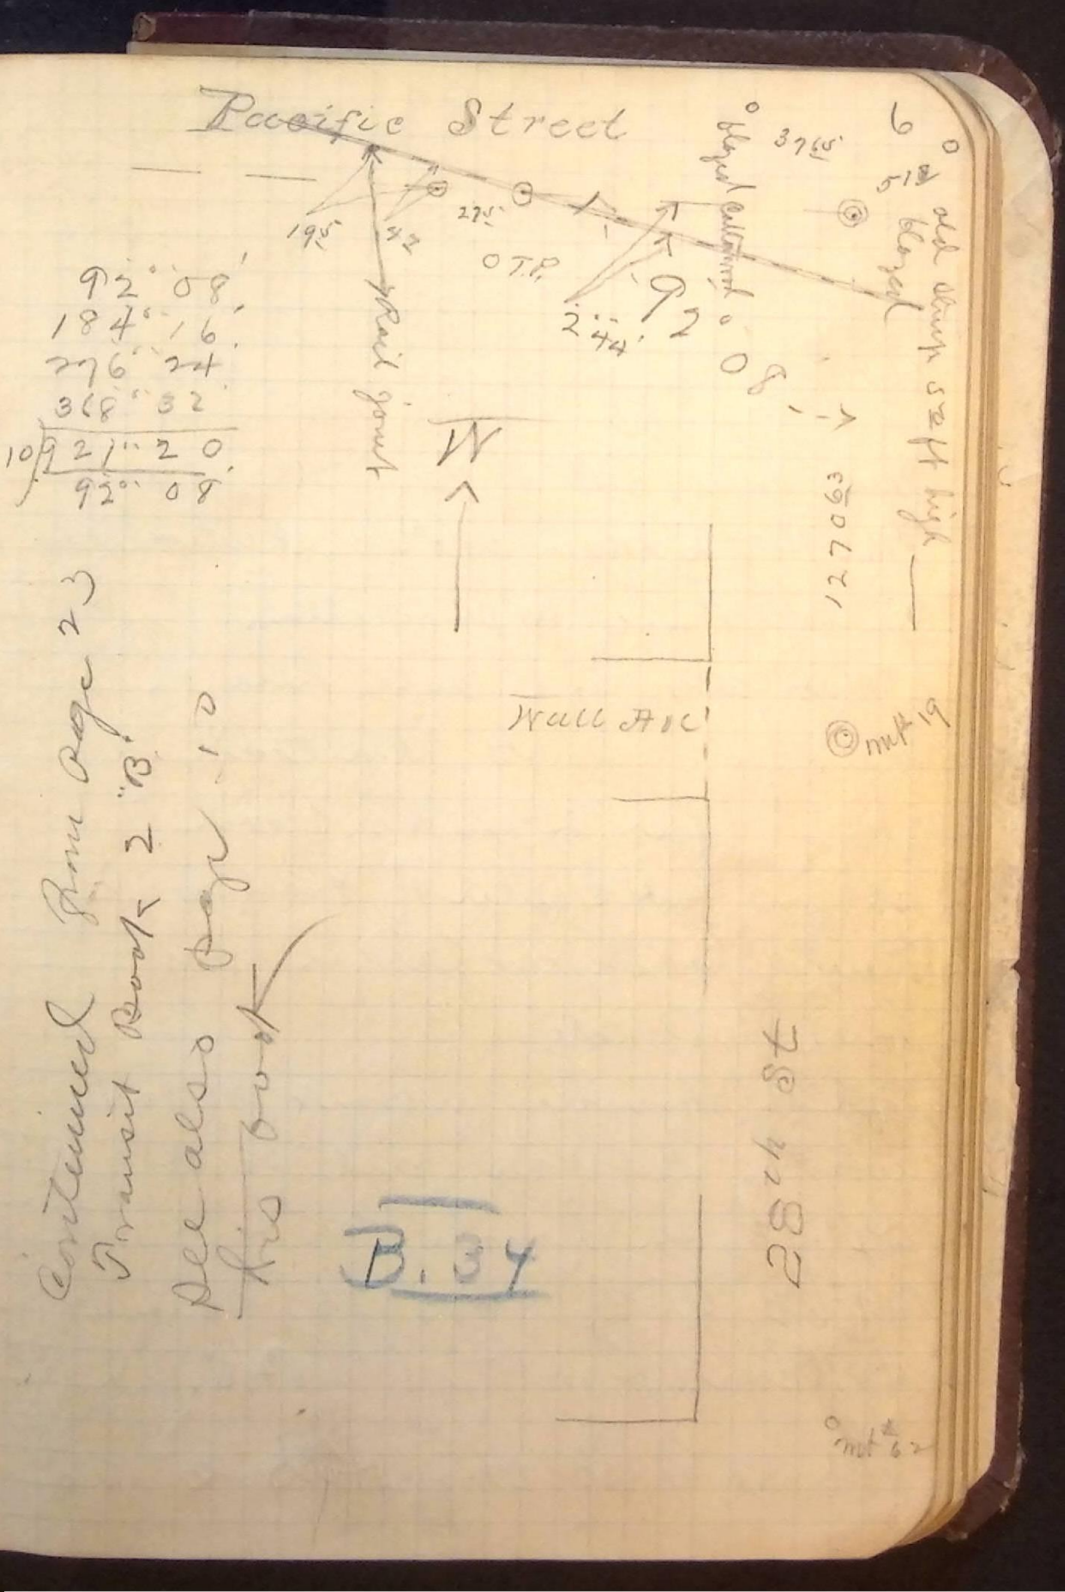
Thursday A.M. May 22nd 1890