


K

\*

5

Sec Corner

SW. Cor 32 TON RIX

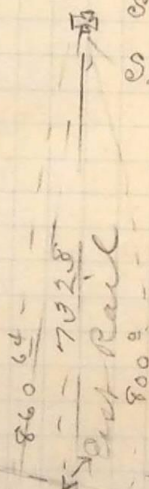

U. P. Main Track

837 Calculated

837 Nut set for Center Pacific

Random line

245  
8 1/4 of Sec 32

B34

cont. page 10

continued from page 7