


20-91  
 also as in  
 B. 34

Paper to Pine Point  
 For ties to which see  
 S.M. cor Pinecastles Lane  
 afterwards planted with 91 -  
 chained north. See diagram  
 Center line of Pacific Avenue  
 Corner of house A.S. on Hub  
 house just over the S.M.

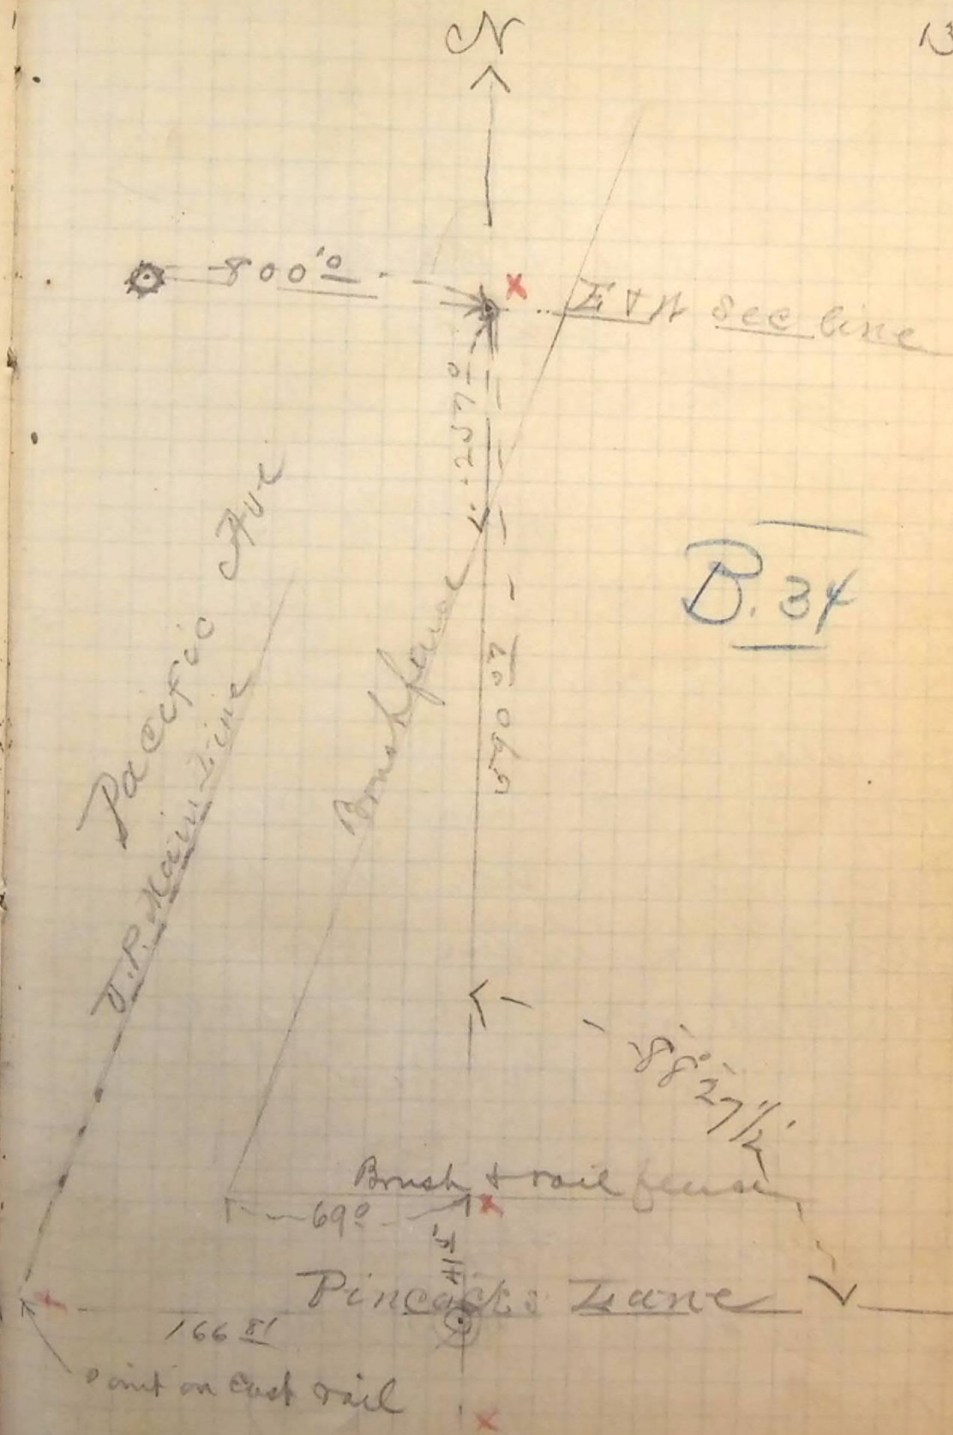

B. 34