See page 4 of

Some water
and concluded to abandon work until
is full now — must wait about 1000 ft
down Center of N.R. Channel — which
this line if produced will run right
Note's

70+00 Ab
70+59 N.R.C. track fence
73+00± U.P. & N. East rail (third point)
73+88 Cross N.P.S. min fence R.S.N.U.P.& N. Ry
on old U.S. bank (here see diagram B)
110± offset mst of wall on N. coming towards
Weber River.
70 N. Strut Wall are mst to
Survey for the opening of
Thursday Aft. May 29th 1890

B 35

See Page 4 of

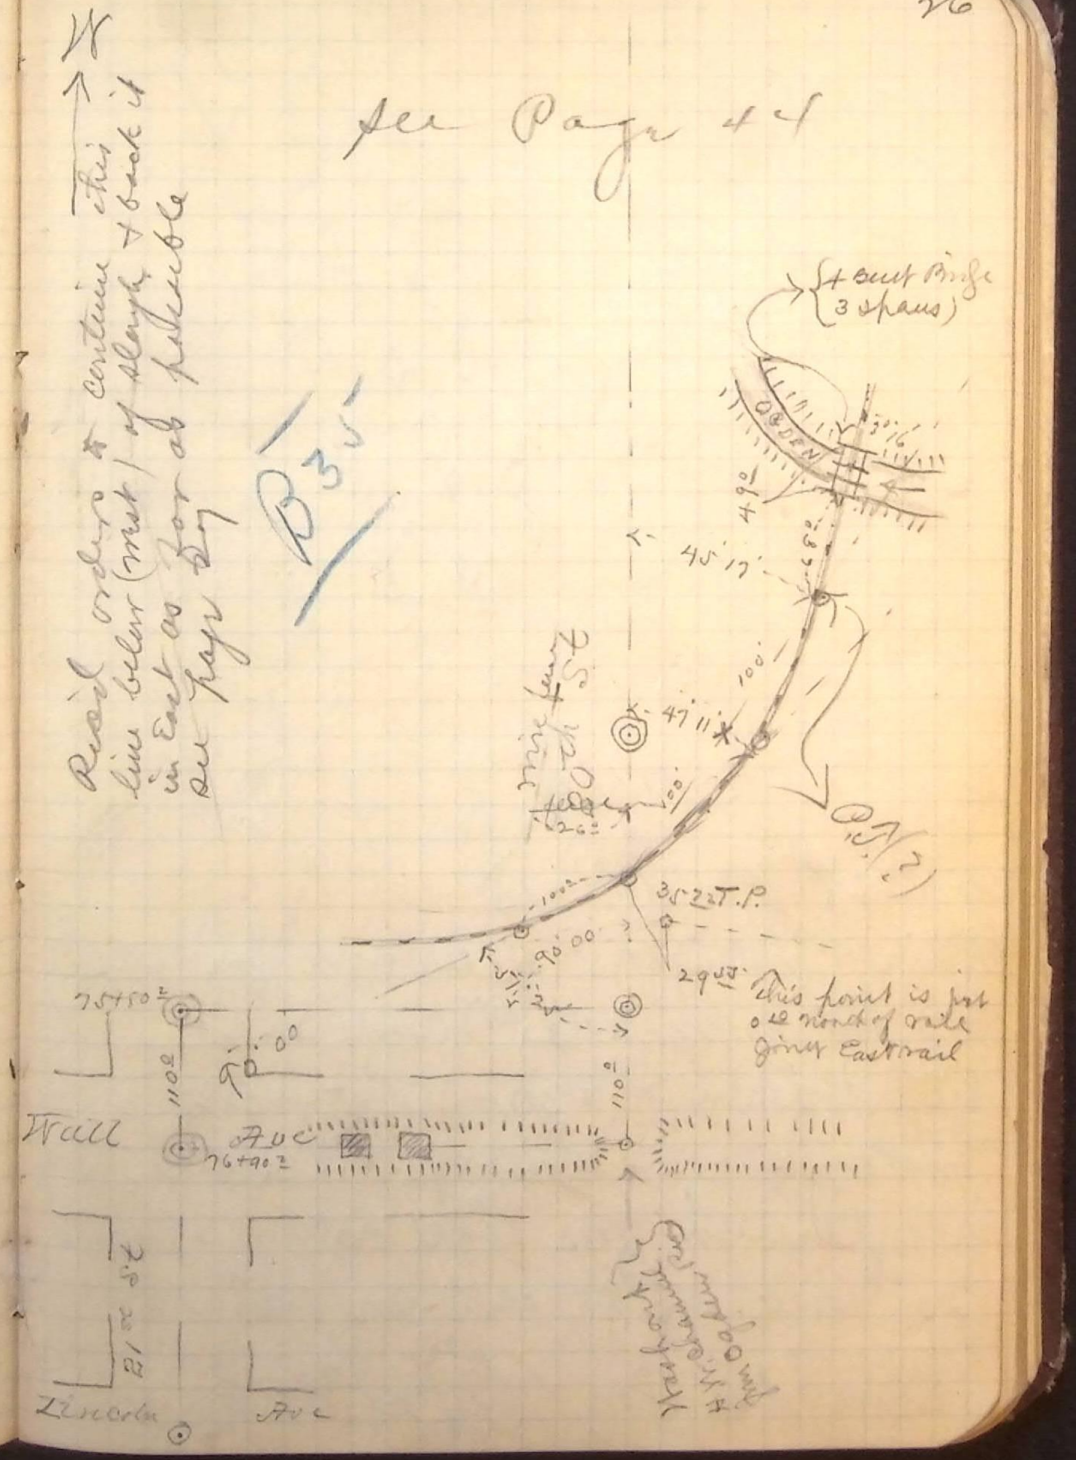
B 35